

**PROPOSED TAKING
AREA = 3,191 SF**

**PROPOSED TAKING
AREA = 3,191 SF**

**PROPOSED ABANDONMENT
AREA = 5,810 SF**

**PROPOSED TAKING
AREA = 2,856 SF**

UTILITY NOTE:

ALL UNDERGROUND UTILITIES SHOWN HERE WERE COMPILED ACCORDING TO AVAILABLE RECORD PLANS FROM VARIOUS UTILITY COMPANIES AND PUBLIC AGENCIES AND ARE APPROXIMATE ONLY. ACTUAL LOCATIONS MUST BE DETERMINED IN THE FIELD BEFORE DESIGNING, EXCAVATING, BUSTING, INSTALLING, BACKFILLING, GRADING, PAVEMENT RESTORATION OR REPAIRING. ALL UTILITY COMPANIES, PUBLIC AND PRIVATE, MUST BE CONTACTED INCLUDING THOSE IN CONTROL OF UTILITIES NOT SHOWN ON THIS PLAN. SEE CHAPTER 370, ACTS OF 1983 MASS. WE ASSUME NO RESPONSIBILITY FOR DAMAGES INCURRED AS A RESULT OF UTILITIES OMITTED OR INACURATELY SHOWN, BEFORE PLANNING FUTURE CONNECTIONS, THE APPROPRIATE PUBLIC UTILITY ENGINEERING DEPARTMENT MUST BE CONSULTED. DIG SAFE TELE. NO. 1-888-344-7233.

DATUM

ELEVATIONS SHOWN REFER TO N.G.V.D. OF 1929. BENCHMARK USED: DSC 79C (FROM FLOOD STUDY REFERENCE MARK 31) MASS DISC IN CONCRETE MONUMENT AT GRADE ABOUT 0.3 MILES NORTH OF EAST ACTON, ON THE WEST SIDE OF NARRAN RAILROAD, 18.6 FEET WEST OF WEST RAIL, 293 FEET NORTH OF THE CENTER OF BROOK STREET. ELEVATION=145.52. BENCHMARK SET: SEE PLAN.

LEGEND:

- ① TREE TO BE REMOVED
- ② NOW OR FORMERLY WETLANDS FLAG
- ③ MILE MARKER
- ④ OAK TREE
- ⑤ MAPLE TREE
- ⑥ BIRCH TREE
- ⑦ ELM TREE
- ⑧ ASH TREE
- ⑨ PINE TREE
- ⑩ WATER GATE
- ⑪ UTILITY POLE
- ⑫ TREE LINE
- ⑬ WATER MAIN (APPROXIMATE)
- ⑭ EXISTING CONTOUR
- ⑮ EDGE OF WETLANDS (DELIMITATED BY ACTION CONS. COMM.)
- ⑯ OVERHEAD WIRES

SIDEWALK PLAN, MAIN STREET
IN
ACTON, MASSACHUSETTS
(MIDDLESEX COUNTY)

FOR: **TOWN OF ACTON**
SCALE: 1" = 20'
MARCH 7, 2007

STAMSKI AND MCNARY, INC.
80 HARRIS STREET - ACTON, MASSACHUSETTS
ENGINEERING - PLANNING - SURVEYING


(3897 SIDEWALK.2.dwg) Sheet 2 of 6 SM-3897



PROPOSED ABANDONMENT
AREA = 5,810 SF±

PROPOSED TAKING
AREA = 7,090 SF±

MAIN STREET - ROUTE 27
(50' WIDE - 1927 COUNTY LAYOUT)

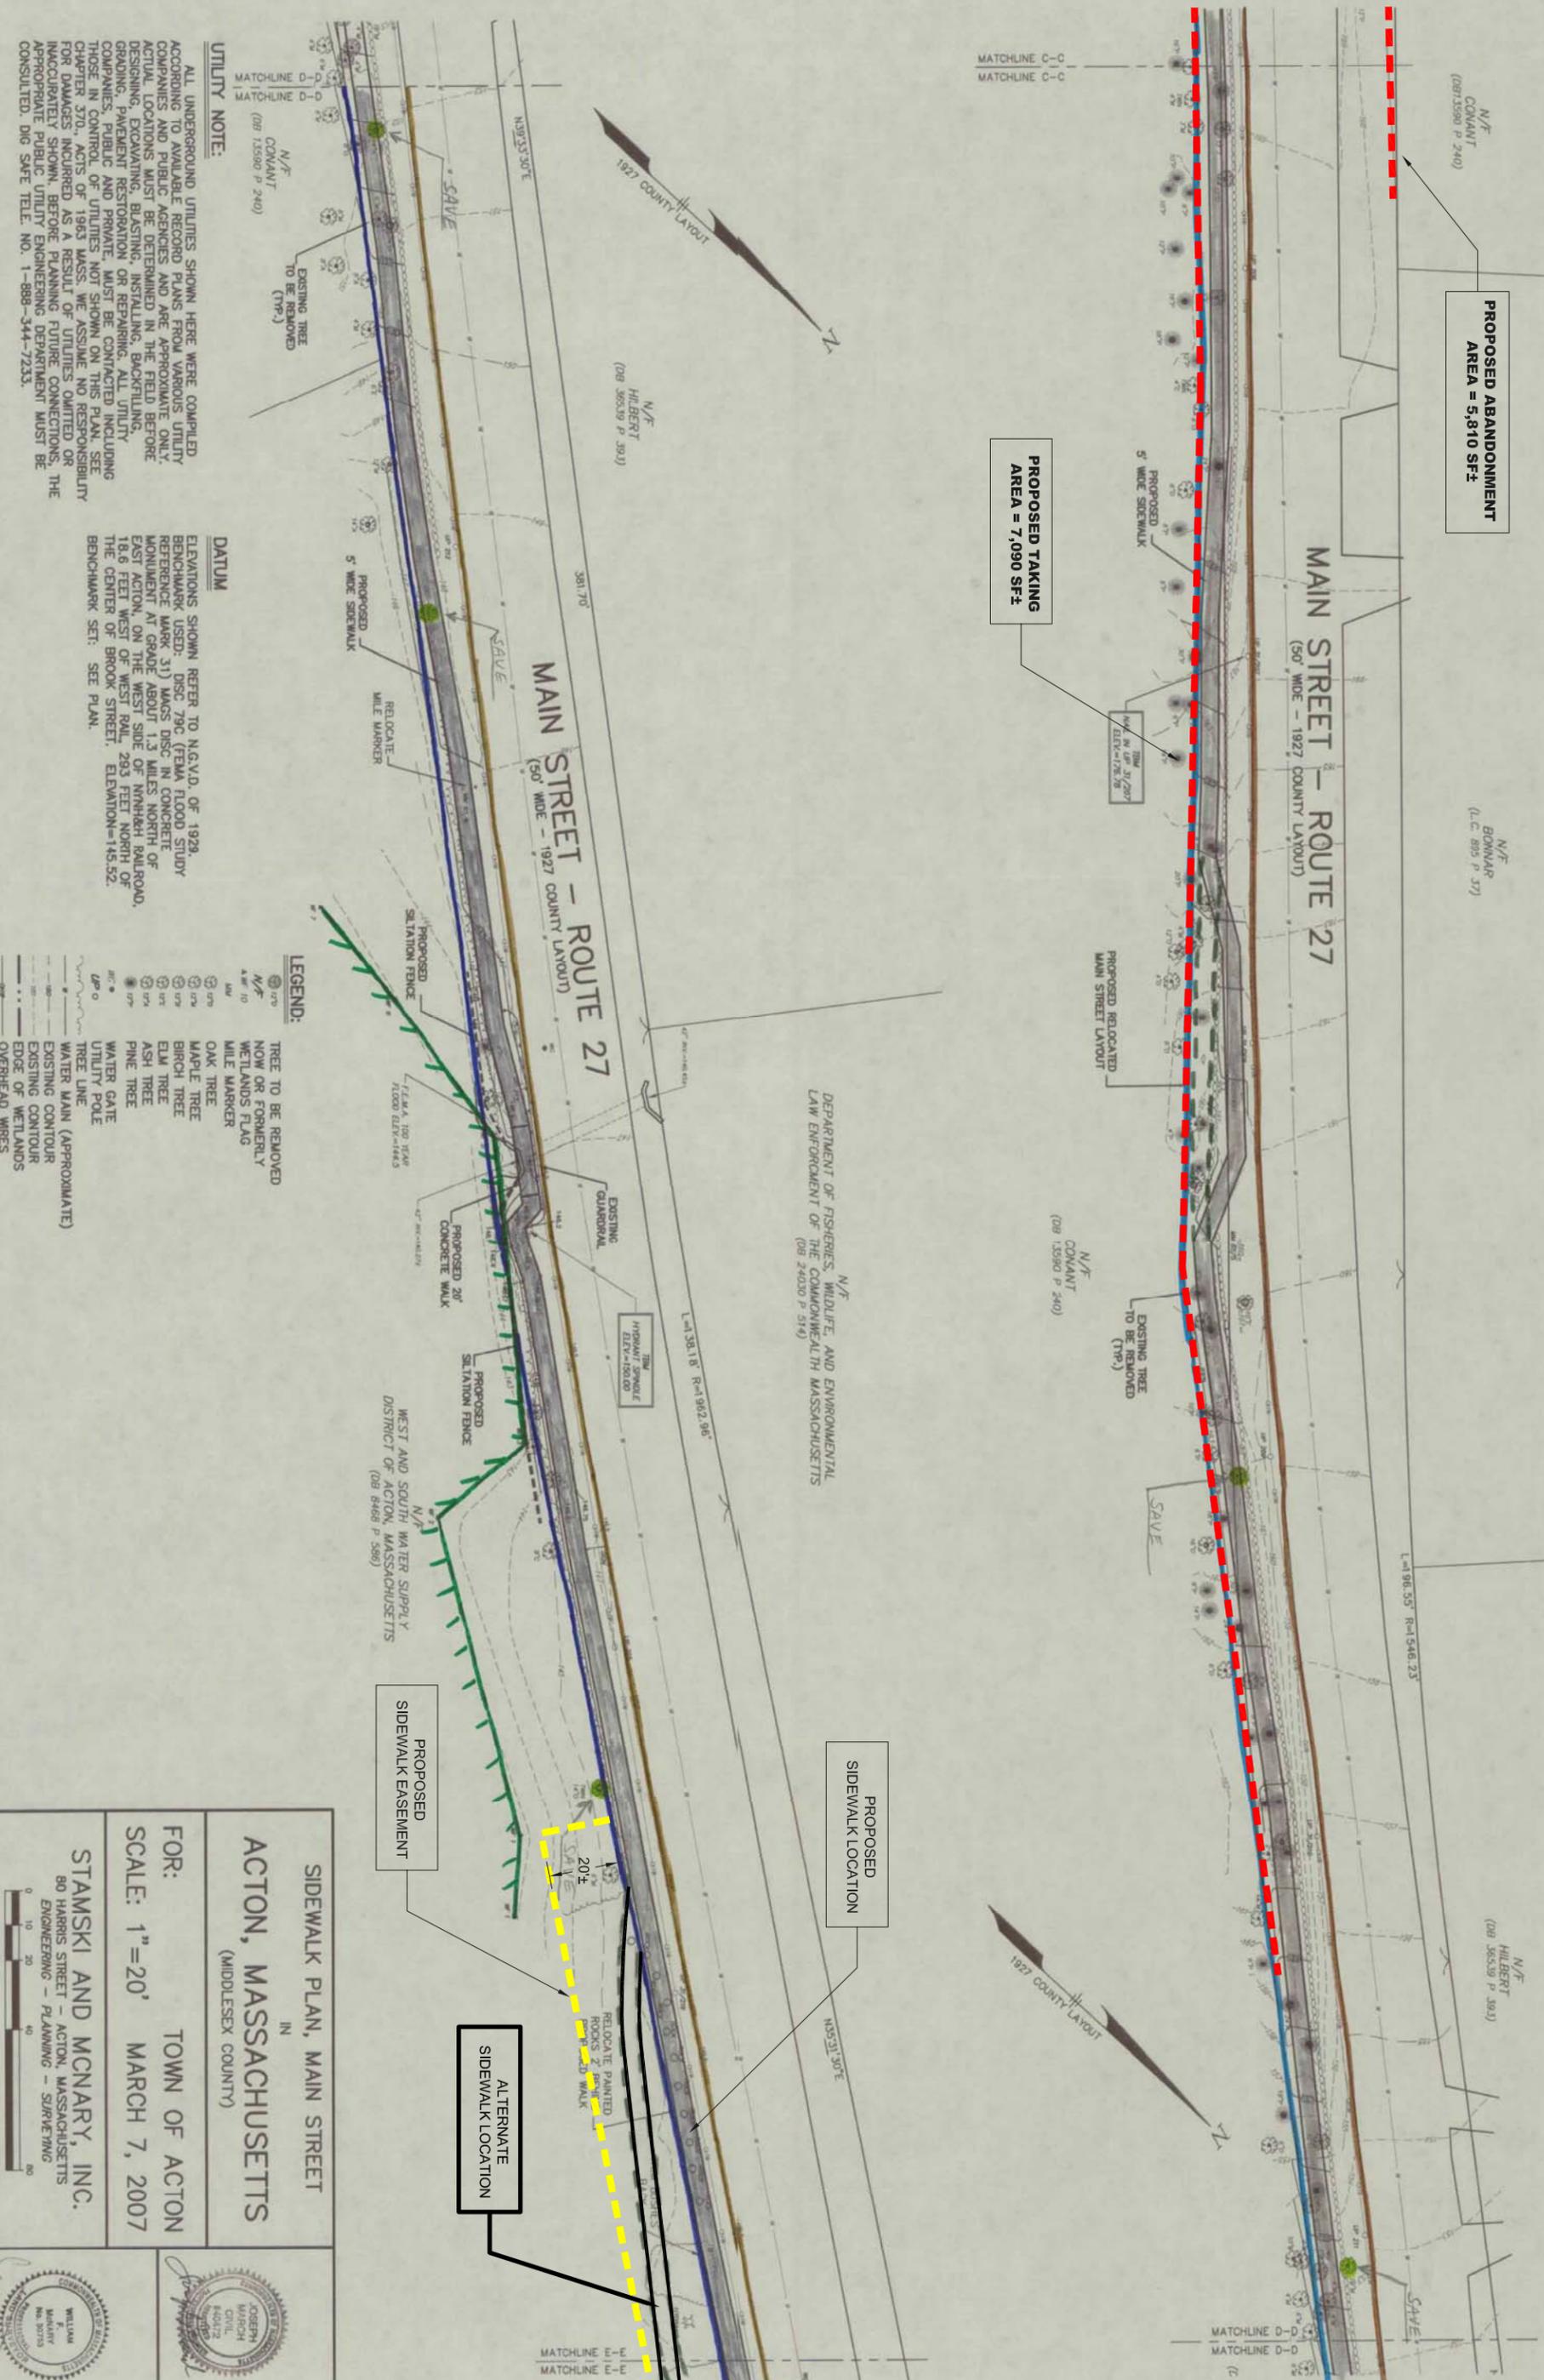

UTILITY NOTE:

ALL UNDERGROUND UTILITIES SHOWN HERE WERE COMPILED ACCORDING TO AVAILABLE RECORD PLANS FROM VARIOUS UTILITY COMPANIES AND PUBLIC AGENCIES AND ARE APPROXIMATE ONLY. ACTUAL LOCATIONS MUST BE DETERMINED IN THE FIELD BEFORE DESIGNING, EXCAVATING, BLASTING, INSTALLING, BACKFILLING, GRADING, PAVEMENT RESTORATION OR REPAIRING. ALL UTILITY COMPANIES, PUBLIC AND PRIVATE, MUST BE CONTACTED INCLUDING THOSE IN CONTROL OF UTILITIES NOT SHOWN ON THIS PLAN. SEE CHAPTER 370, ACTS OF 1963 MASS. WE ASSUME NO RESPONSIBILITY FOR DAMAGES INCURRED AS A RESULT OF UTILITIES OMITTED OR INACCELERATELY SHOWN, BEFORE PLANNING FUTURE CONNECTIONS. THE APPROPRIATE PUBLIC UTILITY ENGINEERING DEPARTMENT MUST BE CONSULTED. DIG SAFE TELE. NO. 1-888-344-7233.

DATUM:

ELEVATIONS SHOWN REFER TO N.G.V.D. OF 1929. BENCHMARK USED: DISC 79C (FEMA FLOOD STUDY REFERENCE MARK 31) MGS DISC IN CONCRETE MOUNTMENT AT GRADE ABOUT 1.3 MILES NORTH OF EAST ACTON, ON THE WEST SIDE OF NINNHAM RAILROAD, 18.6 FEET WEST OF WEST RAIL, 293 FEET NORTH OF THE CENTER OF BROOK STREET. ELEVATION=145.52. BENCHMARK SET: SEE PLAN.

LEGEND:


- TREE TO BE REMOVED
- NOW OR FORMERLY WETLANDS FLAG
- MILE MARKER
- OAK TREE
- MAPLE TREE
- BIRCH TREE
- ELM TREE
- ASH TREE
- PINE TREE
- WATER GATE
- UTILITY POLE
- TREE LINE
- WATER MAIN (APPROXIMATE)
- EXISTING CONTOUR
- EDGE OF WETLANDS
- OVERHEAD WIRES

SIDEWALK PLAN, MAIN STREET
IN
ACTON, MASSACHUSETTS
(MIDDLESEX COUNTY)



FOR: TOWN OF ACTON
SCALE: 1"=20'
MARCH 7, 2007

STAMSKI AND MCNARY, INC.
80 HARRIS STREET - ACTON, MASSACHUSETTS
ENGINEERING - PLANNING - SURVEYING

(3897 SIDEWALK.2.dwg) Sheet 4 of 6 SM-3897

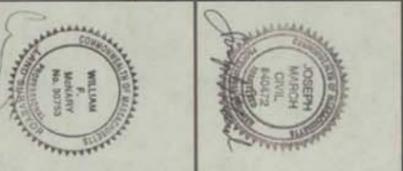

N/F
 DEPARTMENT OF FISHERIES, WILDLIFE, AND ENVIRONMENTAL
 LAW ENFORCEMENT OF THE COMMONWEALTH OF MASSACHUSETTS
 (DB 24030 P 514)

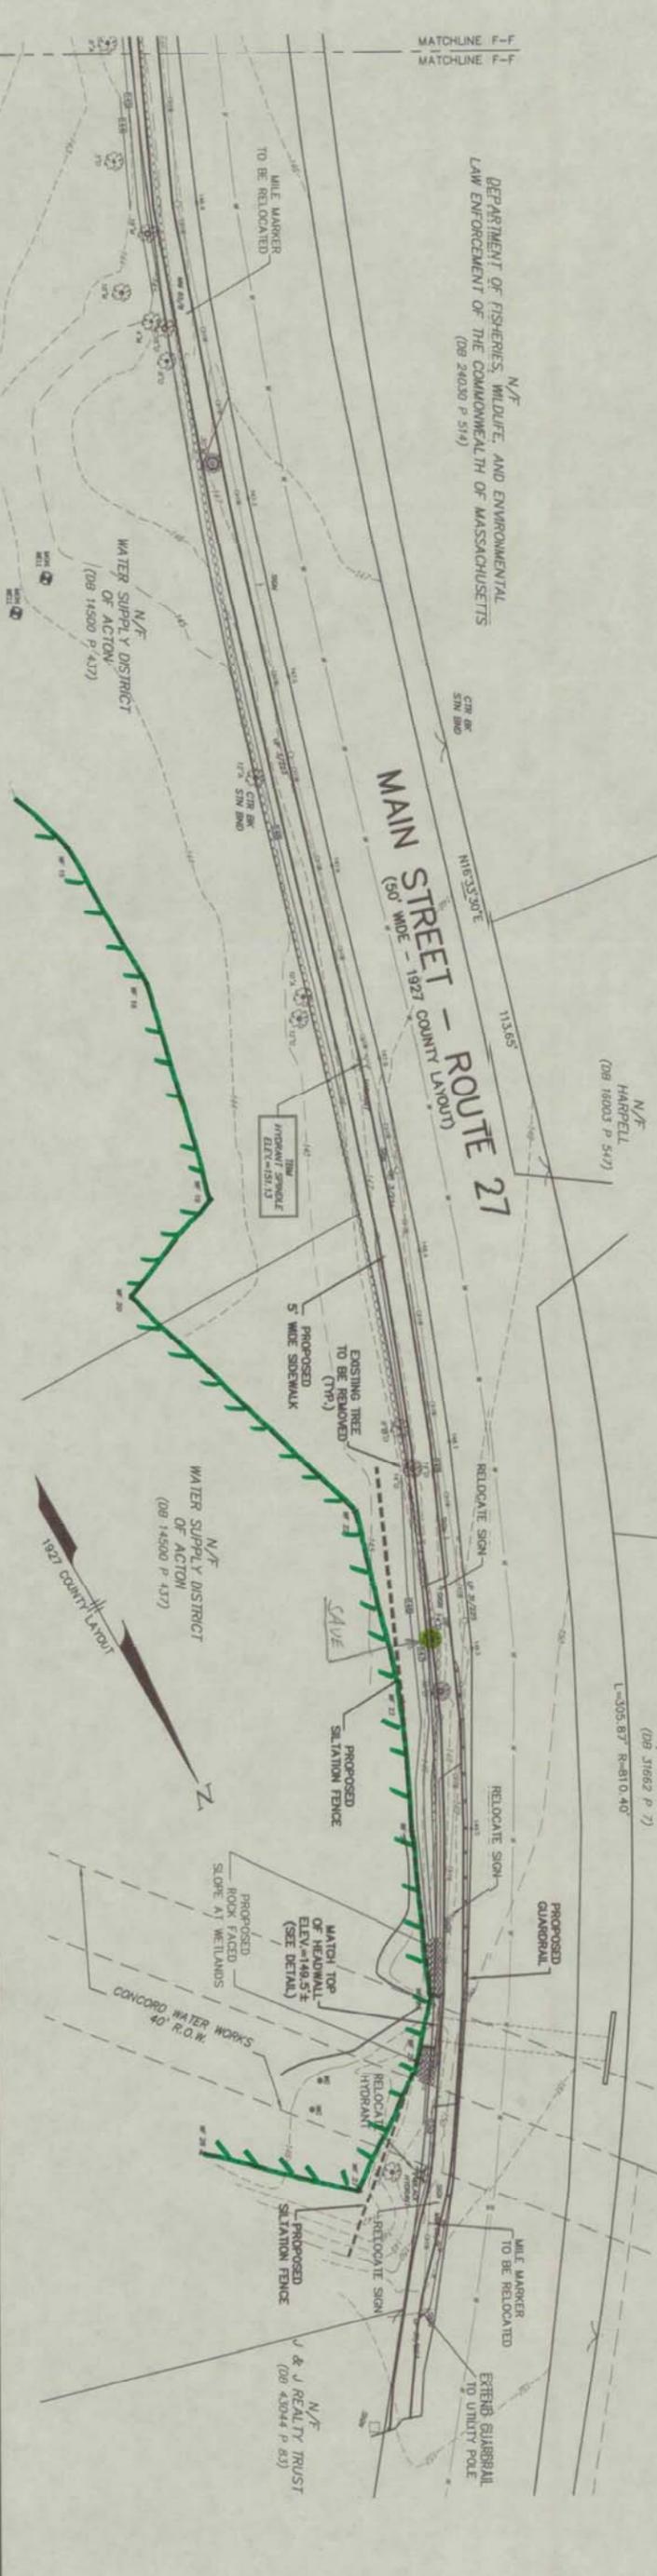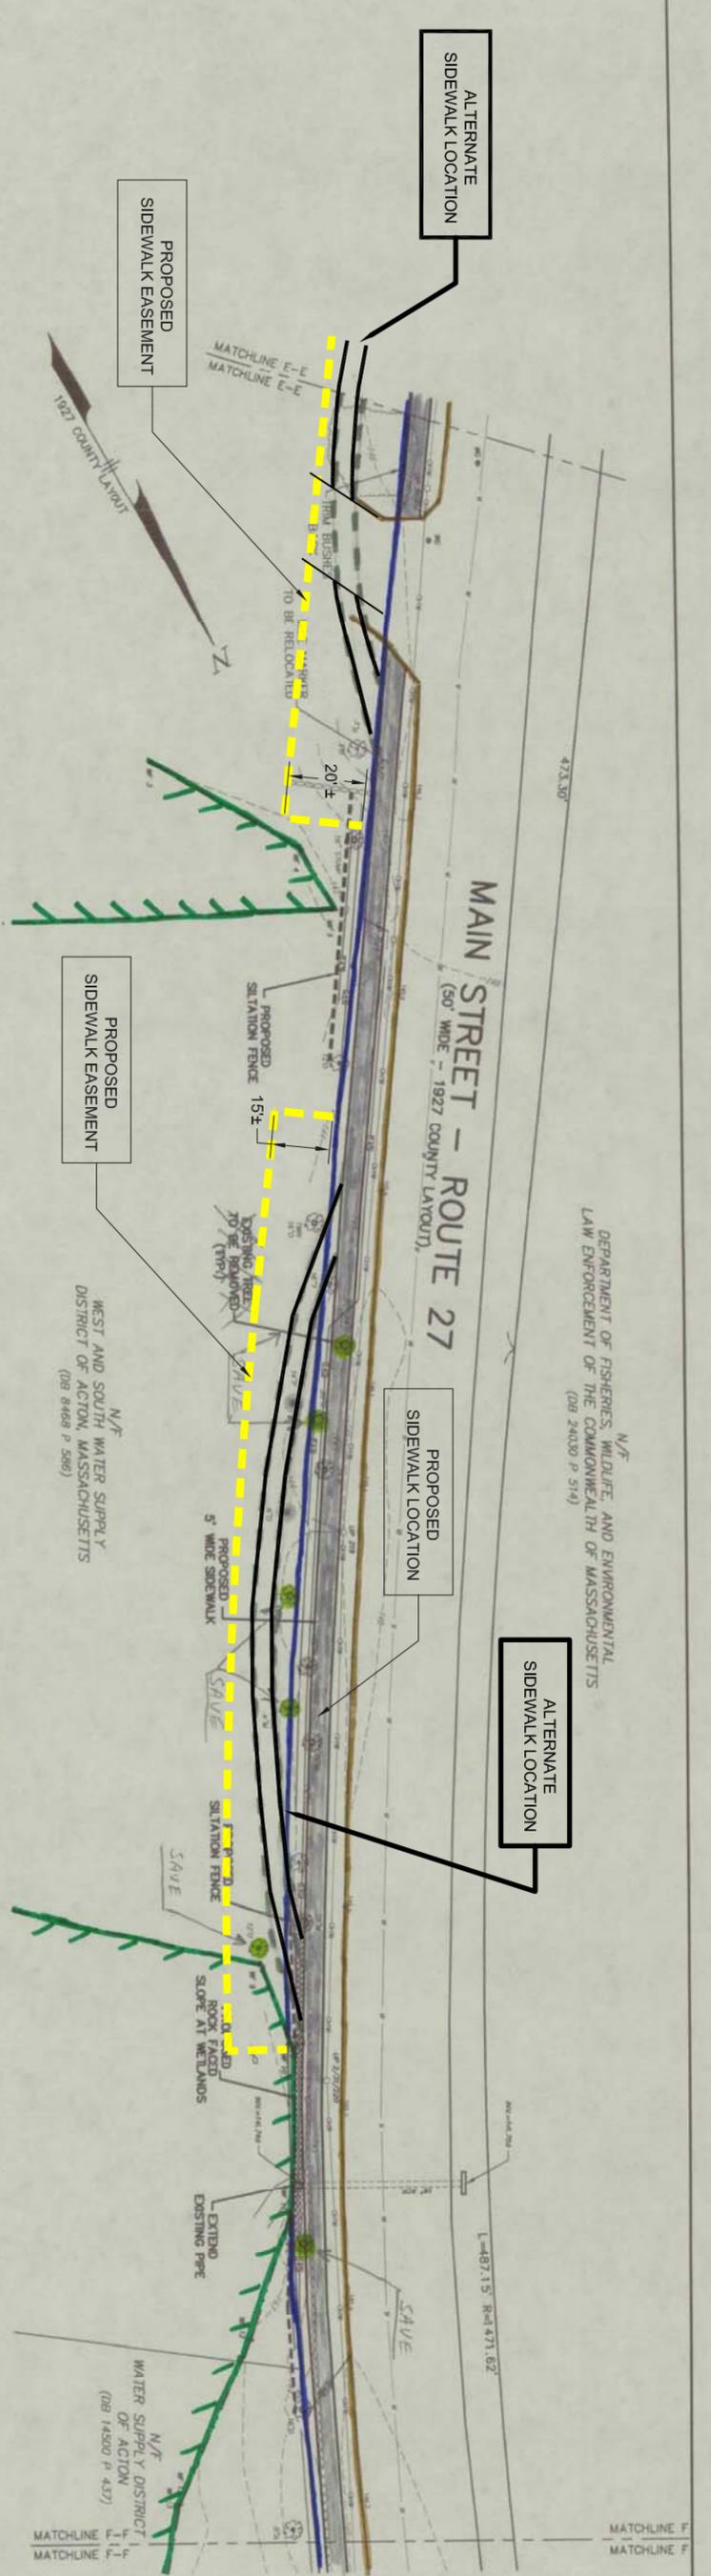

UTILITY NOTE:

ALL UNDERGROUND UTILITIES SHOWN HERE WERE COMPILED ACCORDING TO AVAILABLE RECORDED PLANS FROM VARIOUS UTILITY COMPANIES AND PUBLIC AGENCIES AND ARE APPROXIMATE ONLY. ACTUAL LOCATIONS MUST BE DETERMINED IN THE FIELD BEFORE DESIGNING, EXCAVATING, BLASTING, INSTALLING, BACKFILLING, GRAVING, PAVEMENT RESTORATION, OR REPAIRING. ALL UTILITY COMPANIES, PUBLIC AND PRIVATE, MUST BE CONTACTED INCLUDING THOSE IN CONTROL OF UTILITIES NOT SHOWN ON THIS PLAN. SEE CHAPTER 370, ACTS OF 1963 MASS. WE ASSUME NO RESPONSIBILITY FOR DAMAGES INCURRED AS A RESULT OF UTILITIES OMITTED OR INAPPROPRIATELY SHOWN. BEFORE PLANNING FUTURE CONNECTIONS, THE APPROPRIATE PUBLIC UTILITY ENGINEERING DEPARTMENT MUST BE CONSULTED. DIG SAFE TELE. NO. 1-888-344-7233.

DATUM:

ELEVATIONS SHOWN REFER TO N.G.V.D. OF 1929. BENCHMARK USED: DISC 79C (FEMA FLOOD STUDY REFERENCE MARK 31) MAGS DISC IN CONCRETE MONUMENT AT GRADE ABOUT 1.3 MILES NORTH OF EAST ACTON, ON THE WEST SIDE OF NUNDAH RAILROAD, 18.6 FEET WEST OF WEST RAIL. ELEVATION=145.52. THE CENTER OF BROOK STREET. ELEVATION=145.52. BENCHMARK SET: SEE PLAN.

LEGEND:

- TREE TO BE REMOVED
- NOW OR FORMERLY WETLANDS FLAG
- WILE MARKER
- OAK TREE
- MAPLE TREE
- BIRCH TREE
- ELM TREE
- ASH TREE
- PINE TREE
- WATER GATE
- UTILITY POLE
- WATER MAIN (APPROXIMATE)
- EXISTING CONTOUR
- EDGE OF WETLANDS
- OVERHEAD WIRES

SIDEWALK PLAN, MAIN STREET
 IN
 ACTON, MASSACHUSETTS
 (MIDDLESEX COUNTY)

FOR: TOWN OF ACTON
 SCALE: 1"=20' MARCH 7, 2007

STAMSKI AND MCNARY, INC.
 80 HARRIS STREET - ACTON, MASSACHUSETTS
 ENGINEERING - PLANNING - SURVEYING

(3897 SIDEWALK.2.dwg) Sheet 5 of 6 SM-3897

