



WPA Form 8A – Request for Certificate of Compliance

Massachusetts Wetlands Protection Act M.G.L. c. 131, §40

A. Project Information

Important:

When filling out forms on the computer, use only the tab key to move your cursor - do not use the return key.



Upon completion of the work authorized in an Order of Conditions, the property owner must request a Certificate of Compliance from the issuing authority stating that the work or portion of the work has been satisfactorily completed.

1. This request is being made by:

Mary Ann Reilly, Massachusetts Bay Commuter Rail
Name
32 Cobble Hill Road
Mailing Address
Somerville MA 02143
City/Town State Zip Code
(617) 222-8434
Phone Number

2. This request is in reference to work regulated by a final Order of Conditions issued to:

Mary Ann Reilly, Massachusetts Bay Commuter Rail
Applicant
6/3/2009 85-1019
Dated DEP File Number

3. The project site is located at:

Railroad right-of-way mile post 25.82 Acton
Street Address City/Town
G-2 N/A
Assessors Map/Plat Number Parcel/Lot Number

4. The final Order of Conditions was recorded at the Registry of Deeds for:

Massachusetts Bay Transportation Authority
Property Owner (if different)
Middlesex South 53068 190
County Book Page

Certificate (if registered land)

5. This request is for certification that (check one):

- the work regulated by the above-referenced Order of Conditions has been satisfactorily completed.
 the following portions of the work regulated by the above-referenced Order of Conditions have been satisfactorily completed (use additional paper if necessary).

- the above-referenced Order of Conditions has lapsed and is therefore no longer valid, and the work regulated by it was never started.



WPA Form 8A – Request for Certificate of Compliance

Massachusetts Wetlands Protection Act M.G.L. c. 131, §40

A. Project Information (cont.)


6. Did the Order of Conditions for this project, or the portion of the project subject to this request, contain an approval of any plans stamped by a registered professional engineer, architect, landscape architect, or land surveyor?

Yes If yes, attach a written statement by such a professional certifying substantial compliance with the plans and describing what deviation, if any, exists from the plans approved in the Order.

No

B. Submittal Requirements

Requests for Certificates of Compliance should be directed to the issuing authority that issued the final Order of Conditions (OOC). If the project received an OOC from the Conservation Commission, submit this request to that Commission. If the project was issued a Superseding Order of Conditions or was the subject of an Adjudicatory Hearing Final Decision, submit this request to the appropriate DEP Regional Office (see <http://www.mass.gov/dep/about/region/findyour.htm>).

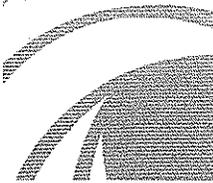

Wannalancit Mills
650 Suffolk Street
Lowell, MA 01854

978.970.5600 PHONE
978.453.1995 FAX

www.TRCSolutions.com

April 15, 2010

Mr. Tom Tidman
Acton Conservation Commission
472 Main St.
Acton, MA 01720

Subject: **Massachusetts Bay Commuter Railroad (MBCR)
Acton Culvert Replacement at Milepost 25.82
DEP File # MADEP No. 85-1019
Request for Certificate of Compliance**

Dear Mr. Tidman:

Attached please find WPA Form 8A – Request for Certificate of Compliance (COC) for the Ayer Culvert Replacement Project at Milepost (MP) 25.82. The culvert replacement was installed by the Massachusetts Bay Commuter Railroad (MBCR) along the Massachusetts Bay Transportation Authority (MBTA) right-of-way. As we discussed on the phone yesterday, I am submitting this cover letter, WPA Form 8A and the stamped as-built plans via email. Please let me know if you would also like any hard copies of the form and/or the stamped full-size as-built plans and I would be happy to provide them.

We are hoping to be placed on the agenda for your next meeting on Wednesday, April 21, 2010. I am still working on the possible scheduling for a site visit on Tuesday, April 20th. I hope to be in touch with you soon to confirm. If we cannot schedule a site visit prior to the hearing, we will likely request to postpone the hearing for the COC until the next meeting so that we have additional time to schedule the site walk.

I look forward to discussing the Project with you. Please let me know if you will need any additional information prior to the hearing. If you have any other questions feel free to contact me at 978-656-3608.





Sincerely,

Sabrina Hepburn



cc: Mary Ann Reilly, MBCR
Samantha Hard, TRC

GENERAL NOTES:

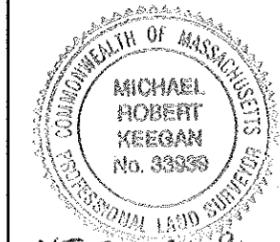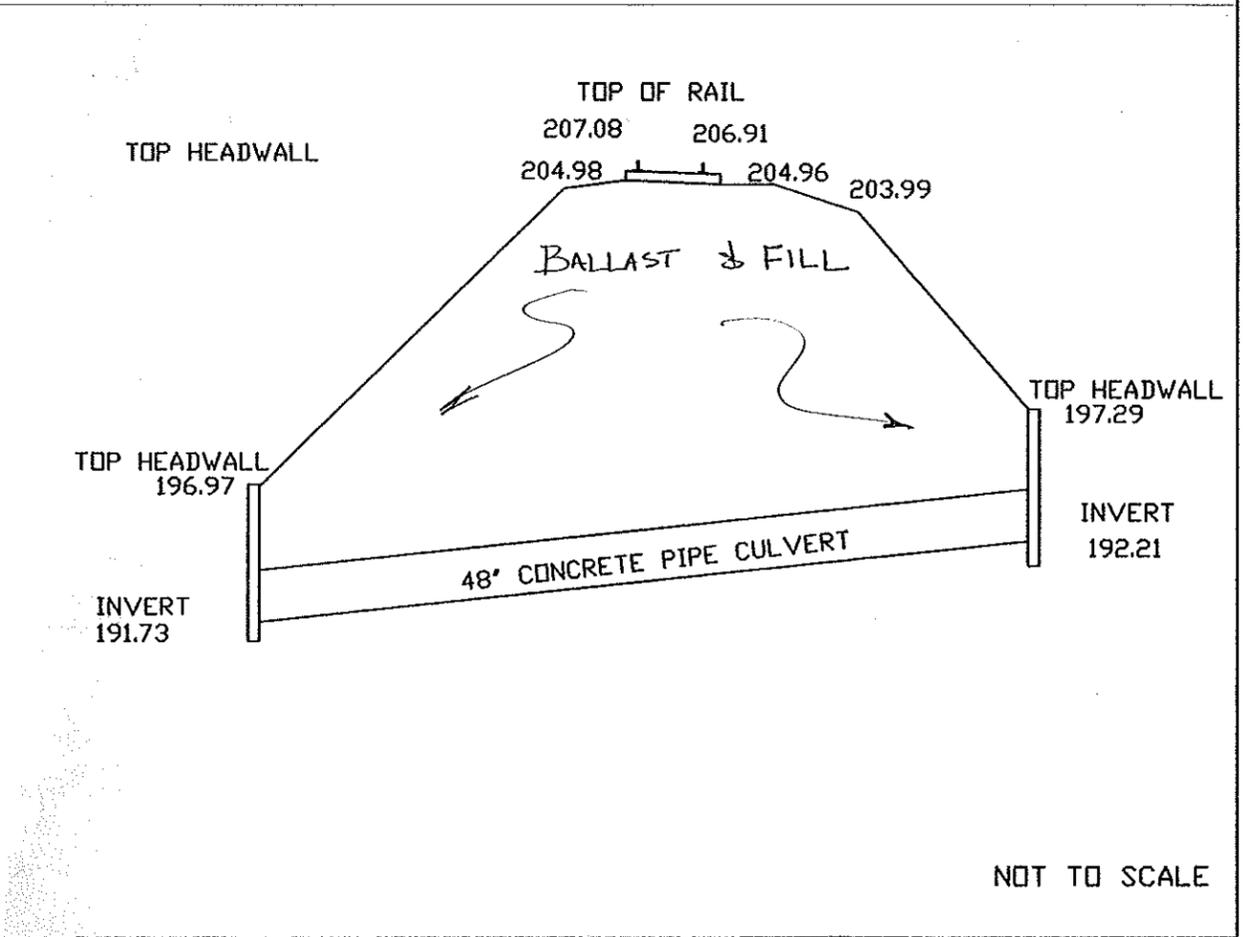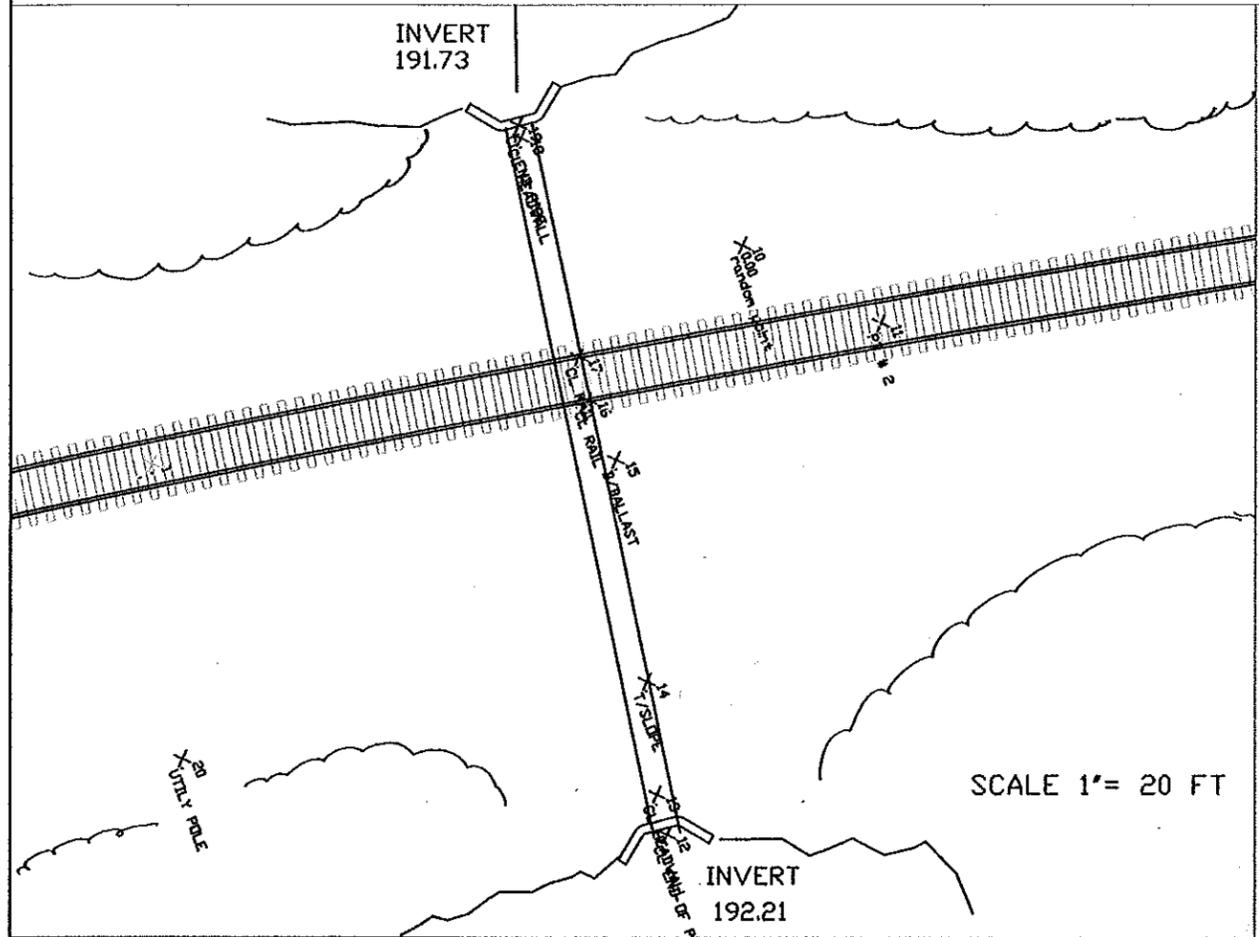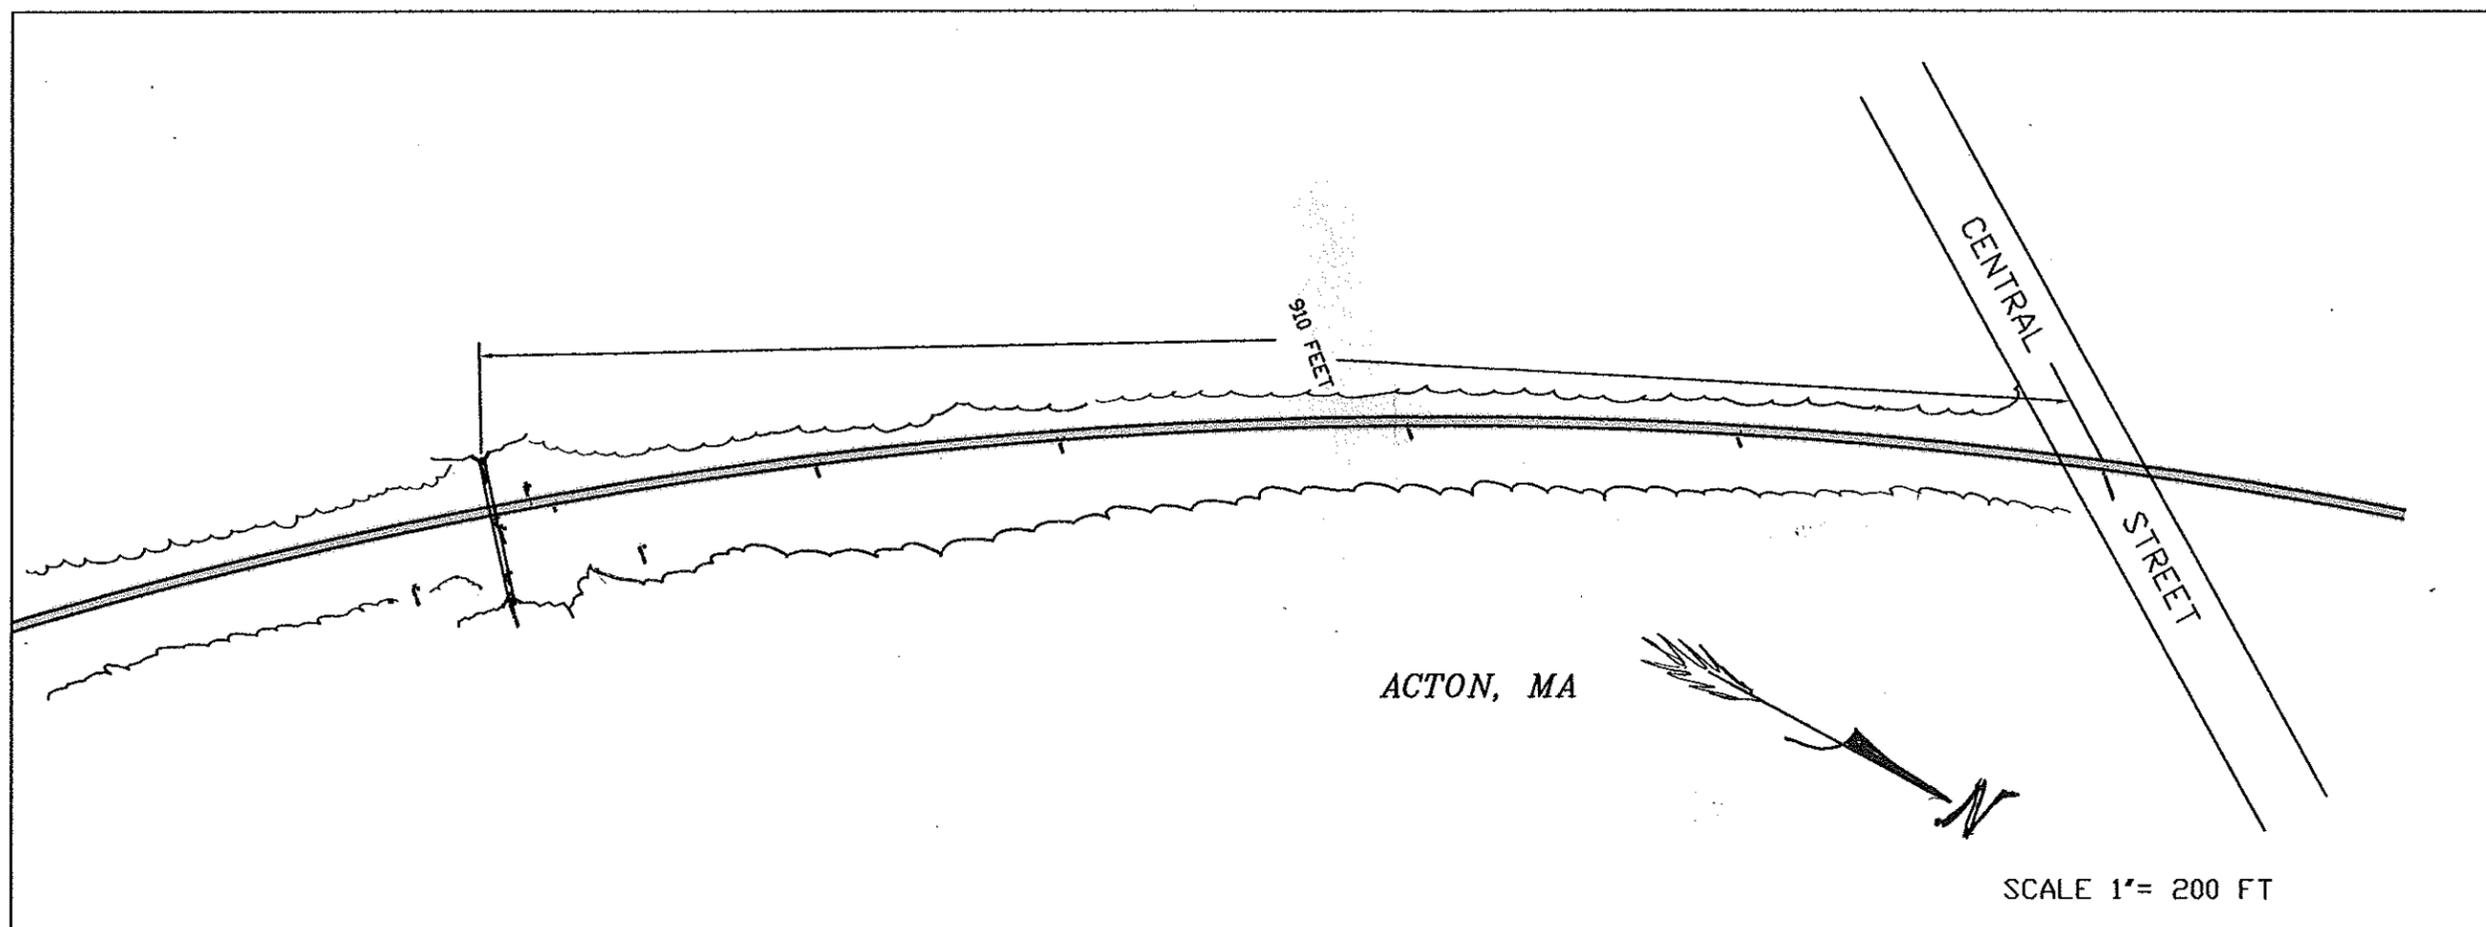

OCT 23, 2009
 Michael Robert Keegan

| No. | Revision/Issue | Date |
|-----|----------------|------|
| | | |

CULVERT ASBUILT
 ACTON, MA
 MBTA RAIL LINE
 BOSTON TO FITCHBURG LINE

| | |
|----------------------|-----------------|
| Date: SEPT, 05, 2009 | Scale: AS NOTED |
| Drawn By: MRK | |
| | |