

Date..... 4/9/04.....

Permit No..... 04-17.....

TOWN OF ACTON

APPLICATION FOR PERMIT TO CONSTRUCT WITHIN A PUBLIC WAY

This application must be submitted not less than five (5) days prior to any Construction within a public way.

Notice 24 hours in advance of any construction must be given to the Town Engineer.

- 1. Permittee: Kegon Energy Address: 50 Second Ave Waltham, MA 02451
- 1A. Telephone #: 781-335-1157
- 2. Location of Proposed Construction: 39 Piper Rd
- 3. Purpose of Construction: Install New Gas Service
- 4. Length of Cut: 20'
- 5. Width of Cut: 15'
- 6. Width of Existing Pavement:
- 7. Type of Existing Roadway Surface: Asphalt Type of Curb:
- 8. Type of Existing Sidewalk Surface:
- 9. Date of Street Opening: From
- 10. For Work Involving Excavations: Dig Safe Number 2004408629

I, the undersigned, hereby declare that I have read and agree to the Town of Acton Specifications for Regulating Construction with Public Ways dated January 8, 1991. I have deposited the required bond with the Town of Acton, and I covenant and agree that the Town may deduct from this amount the cost of repairs to the road surface, curbs, shoulders, walls or other features within the right-of-way including replacing bounds if not completed by me to the satisfaction of the Town Engineer within the specified time.

Special Instructions:

Signature of Applicant..... Edward J. Capin.....

Piper Road Pavement - 1997
Plans 1188 of 1995 (lot 2B) - Stone wall along frontage
- no road bounds


If possible, please utilize one of the two driveways for the new gas service.

Permit Issued: Date 4/9/04 By: gy

Application Denied: Date


Work Inspected and Approved: Date

**TOWN OF ACTON
TYPICAL DRIVEWAY 8
TRENCH DETAIL
FEB. 1969
NO SCALE**

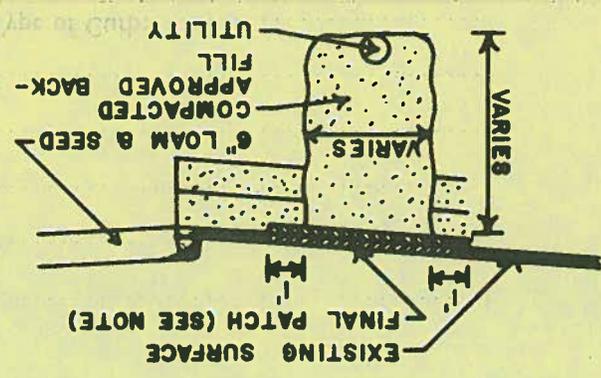

NOTE: 1. FINAL PATCH DEPTH
3" OIL TREATED ROADS
4" BIT. CONC. ROADS
2. SEE SPECIFICATIONS FOR
FURTHER REQUIREMENTS

SKETCH

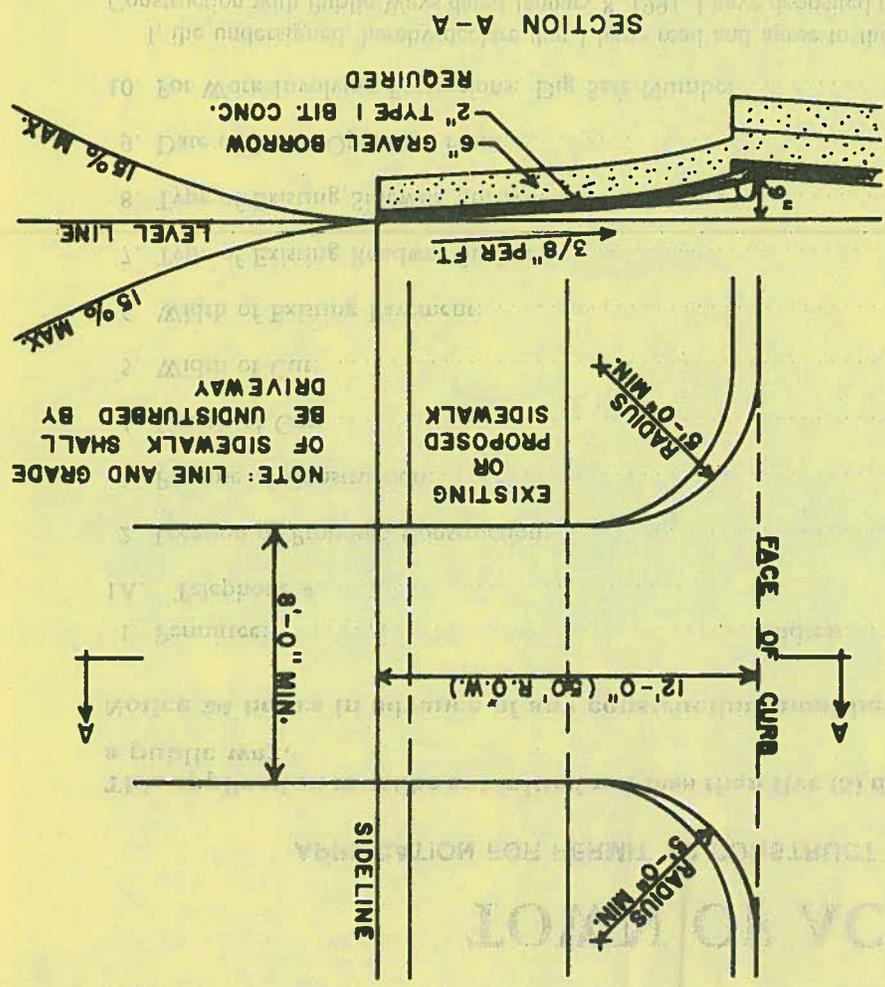

6" GRAVEL BORROW
2" TYPE 1 BIT. CONC.
REQUIRED

Date..... 4/9/04

Permit No..... 04-11

TOWN OF ACTON

APPLICATION FOR PERMIT TO CONSTRUCT WITHIN A PUBLIC WAY

This application must be submitted not less than five (5) days prior to any Construction within a public way.

Notice 24 hours in advance of any construction must be given to the Town Engineer.

- 1. Permittee: *Kaygan Energy* Address: *57 Second Ave. Northam. 01457*
- 1A. Telephone #: *781-335-2855*
- 2. Location of Proposed Construction: *39 Piper Rd*
- 3. Purpose of Construction: *Install New Gas Service*
- 4. Length of Cut: *20'*
- 5. Width of Cut: *15'*
- 6. Width of Existing Pavement:
- 7. Type of Existing Roadway Surface: *Asphalt* Type of Curb:
- 8. Type of Existing Sidewalk Surface:
- 9. Date of Street Opening: From
- 10. For Work Involving Excavations: Dig Safe Number *20041168629*

I, the undersigned, hereby declare that I have read and agree to the Town of Acton Specifications for Regulating Construction with Public Ways dated January 8, 1991. I have deposited the required bond with the Town of Acton, and I covenant and agree that the Town may deduct from this amount the cost of repairs to the road surface, curbs, shoulders, walls or other features within the right-of-way including replacing bounds if not completed by me to the satisfaction of the Town Engineer within the specified time.

Special Instructions:

Signature of Applicant..... *Edward J. Caproni*

*Piper Road Pavement - 1997
Plans 1188 of 1995 (lot 2B) - Stone wall along frontage
- no road bounds*

If possible, please utilize one of the two driveways for the new gas service.

Permit Issued: Date *4/9/04* By: *gj*

Application Denied: Date

Work Inspected and Approved: Date

Work prepared and approved: DATE

BY:


Approval Date: DATE

BY:


Revised Date: DATE

BY:


SKETCH

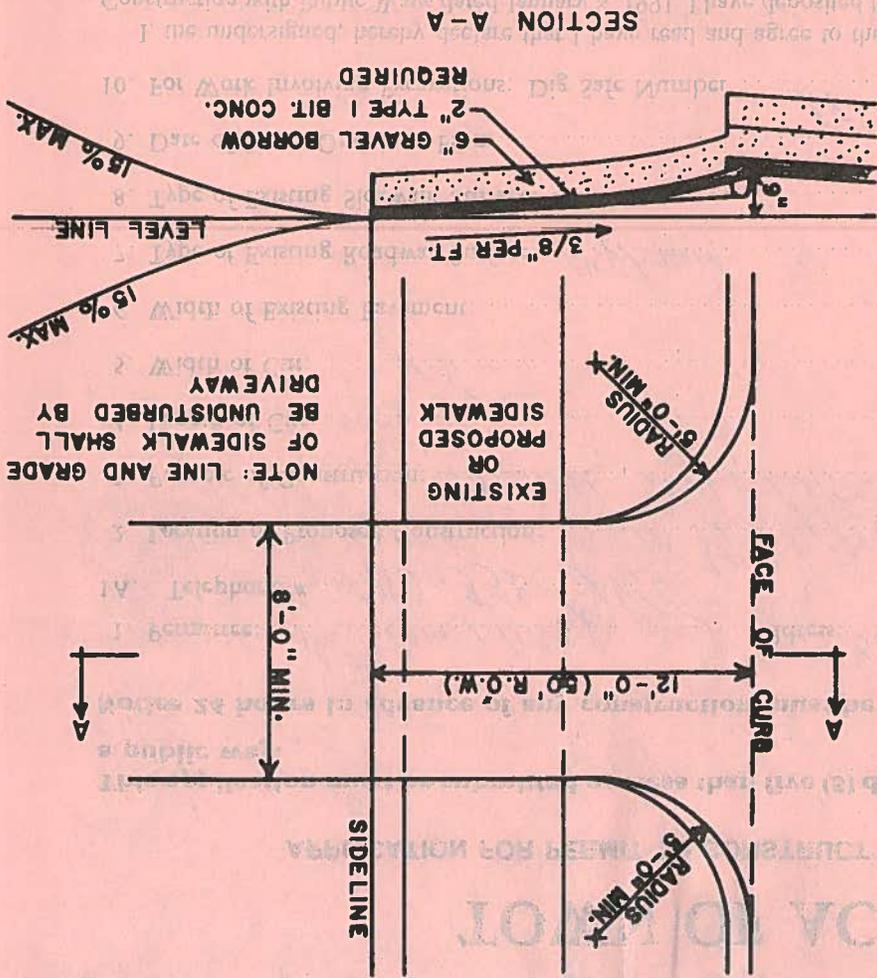

NOTE: 1. FINAL PATCH DEPTH
 3" OIL TREATED ROADS
 4" BIT. CONC. ROADS
 2. SEE SPECIFICATIONS FOR
 FURTHER REQUIREMENTS

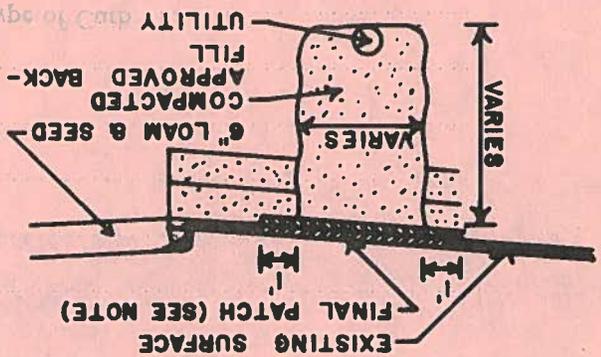

TOWN OF ACTON
 TYPICAL DRIVEWAY 8
 TRENCH DETAIL
 FEB. 1969
 NO SCALE

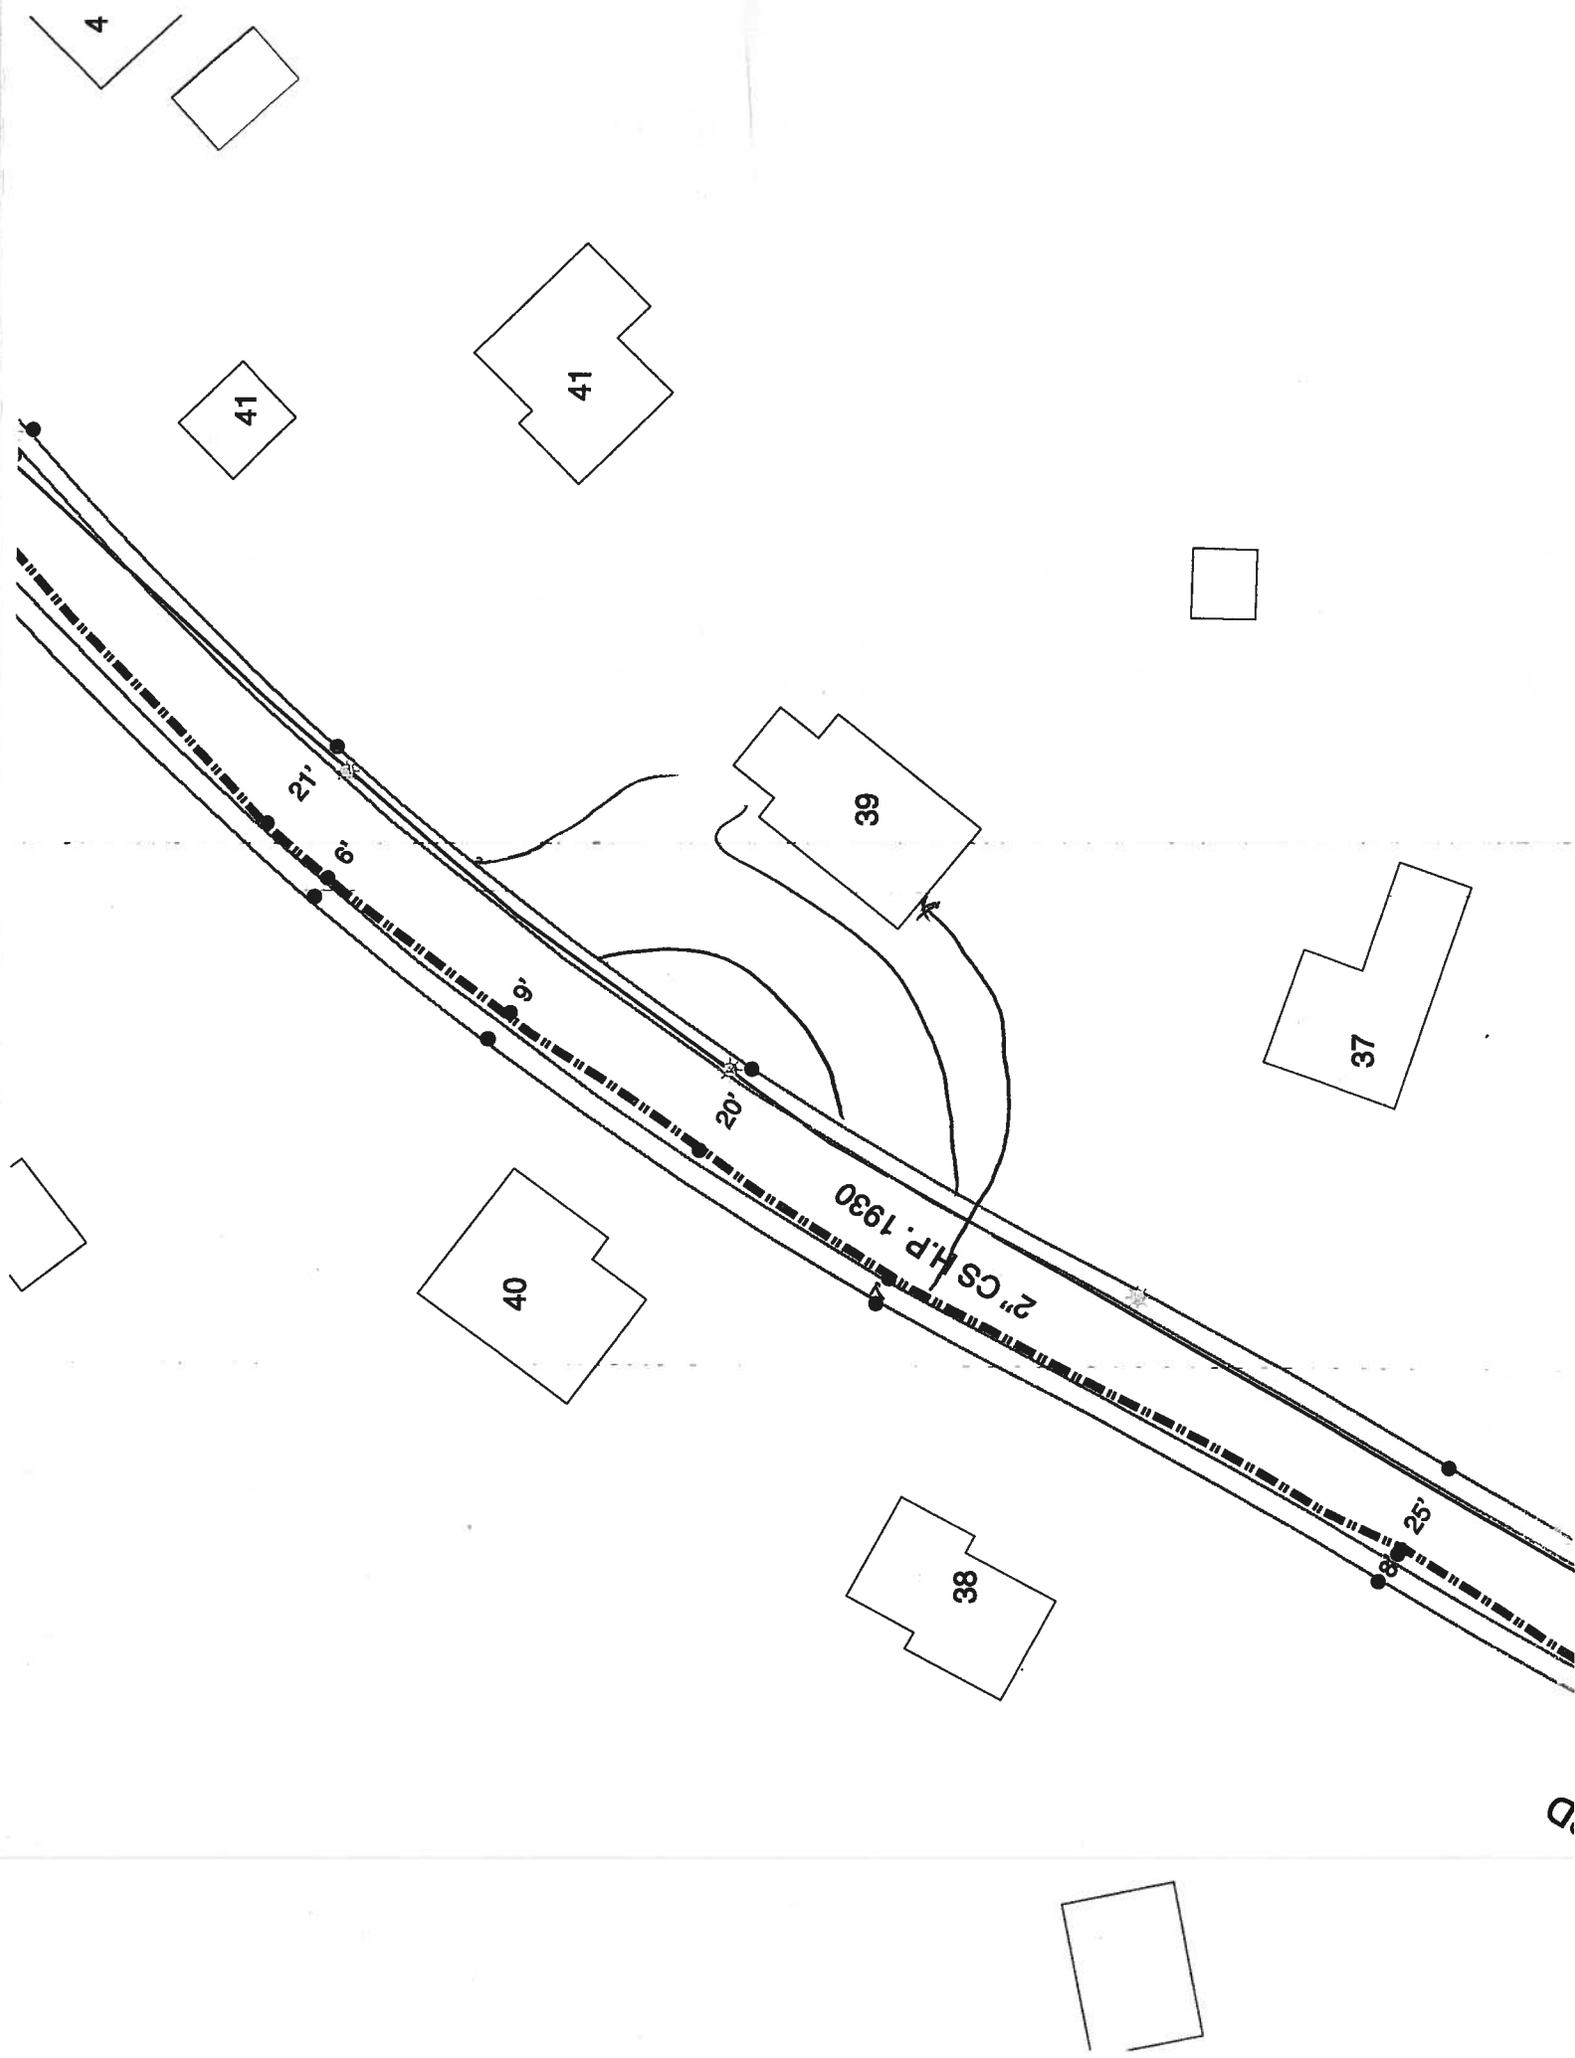


5661 to 811 ✓

SEE THE FOLLOWING PLANS AND DEEDS RECORDED AT WORCESTER SOUTH DISTRICT REGISTER OF DEEDS
 BOOK 2288 PAGE 170 - PLAN BY E.H. KETTERING, DATED MAY 14, 1948
 BOOK 2288 PAGE 480 - DEED TO THOMAS H. & JAMES E. HART
 BOOK 2288 PAGE 480 - DEED TO THOMAS H. & JAMES E. HART
 BOOK 10137 PAGE 448 - DEED TO THOMAS H. & JAMES E. HART
 BOOK 34031 PAGE 388 - DEED TO THE COFFEY FAMILY TRUST

ZONING: RESIDENCE 2 (R-2)
 TOWN OF ACTON
 MAP G-3 PARCEL 207 (PART)
 MAP H-3 PARCEL 7 (COFFEY)

NOTE: THIS PLAN HAS BEEN PREPARED TO ACCURATELY REPRESENT THE LINE AGREEMENTS BETWEEN THE PARTIES TO CORRECT ERRORS AND DISTANCES ON CURRENT PLAN OF RECORD IN BOOK 7353 PAGE 448

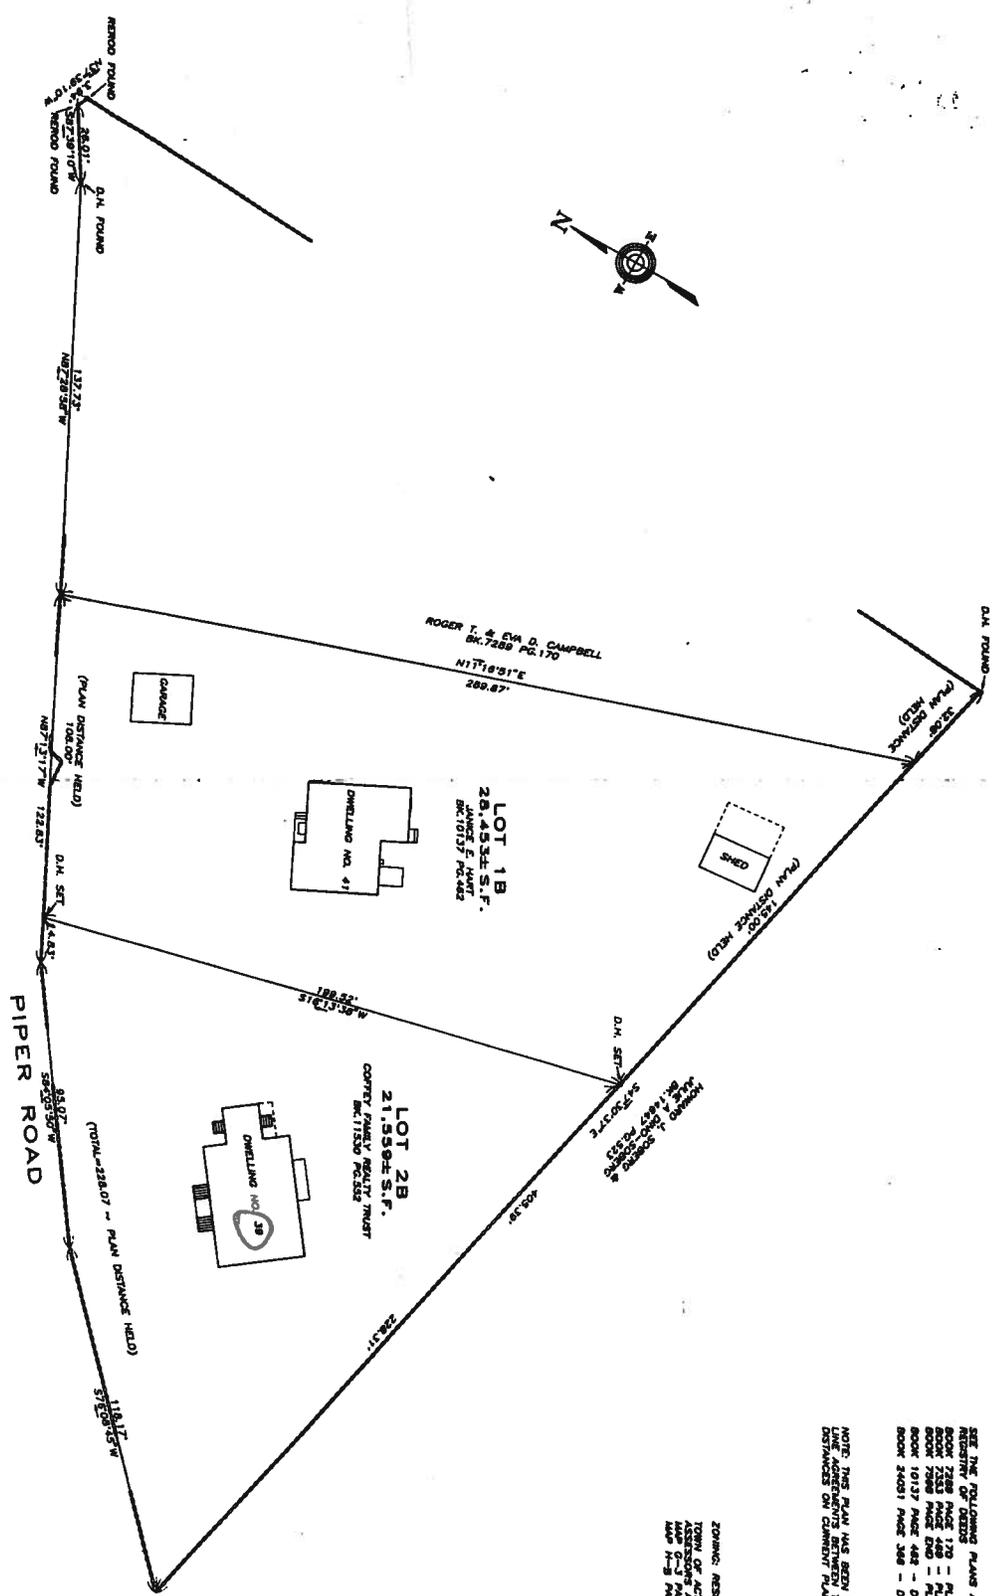

Massachusetts Registry of Deeds,
 Southern District

Order of Massachusetts
 Plan No. 1994 of 1994
 Filed for Record on May 18, 1994
 GUILDFORD Doc No. 1994-0018
 Page 1
 JOHN E. DUNN, G.L.F.L.S.22158
 DATE: MAY 18, 1994

ACTION PLANNING BOARD
 APPROVAL UNDER THE SUBDIVISION
 CONTROL LAW NOT REQUIRED.
 DATE: JAN 18, 1995
John E. Dunn

PLAN OF LAND
 IN
ACTON, MASS.
 OWNED BY JAMES E. HART AND THE
 COFFEY FAMILY REALTY TRUST

SCALE: 1 INCH = 20 FEET
 DECEMBER 1, 1994
 ACTON SURVEY & ENGINEERING, INC.
 277 CENTRAL ST. - ACTON - MASS.



