



- LEGEND:**
- - - - - EXISTING CONTOUR
  - - - - - NOW OR FORMERLY
  - - - - - OVERHEAD WIRES
  - - - - - UTILITY POLE
  - - - - - BORDERING VEGETATED WETLAND
  - - - - - 100' BUFFER ZONE
  - - - - - PROPOSED UNDERGROUND UTILITIES
  - - - - - APPROX. EXISTING GAS MAIN
  - - - - - APPROX. EXISTING WATER MAIN
  - - - - - APPROX. EXISTING GAS SERVICE
  - - - - - EXISTING TREELINE
  - - - - - PROPOSED TREELINE
  - - - - - EXISTING BRUSHLINE
  - - - - - PROPOSED CONTOUR
  - - - - - PROPOSED SPOT GRAUVE
  - - - - - DRAIN MANHOLE
  - - - - - CATCH BASIN
  - - - - - SEWER MANHOLE
- 201.07
- DMH
  - CB
  - SMH

**GENERAL NOTES**

1. ALL ELEVATIONS ARE BASED ON MAGS IN CONC. MON. "170G", N.G.V.D.
2. ALL UNDERGROUND UTILITIES SHOWN HEREON WERE COMPILED ACCORDING TO AVAILABLE RECORD PLANS FROM VARIOUS UTILITY COMPANIES AND PUBLIC AGENCIES AND ARE APPROXIMATE ONLY. ACTUAL LOCATIONS MUST BE DETERMINED IN THE FIELD BEFORE EXCAVATING, BLASTING, INSTALLING, BACKFILLING, GRADING, PAVEMENT RESTORATION OR REPAIRING. ALL UTILITY COMPANIES, PUBLIC AND PRIVATE, MUST BE CONTACTED INCLUDING THOSE IN CONTROL OF UTILITIES NOT SHOWN ON THIS PLAN. SEE CHAPTER 370, ACTS OF 1963 MASS. WE ASSUME NO RESPONSIBILITY FOR DAMAGE INCURRED AS A RESULT OF UTILITIES OMITTED OR INACCURATELY SHOWN. BEFORE PLANNING FUTURE CONNECTIONS, THE APPROPRIATE PUBLIC UTILITY ENGINEERING DEPARTMENT MUST BE CONSULTED. DIG-SAFE TELE. NO. (888) 344-7233.

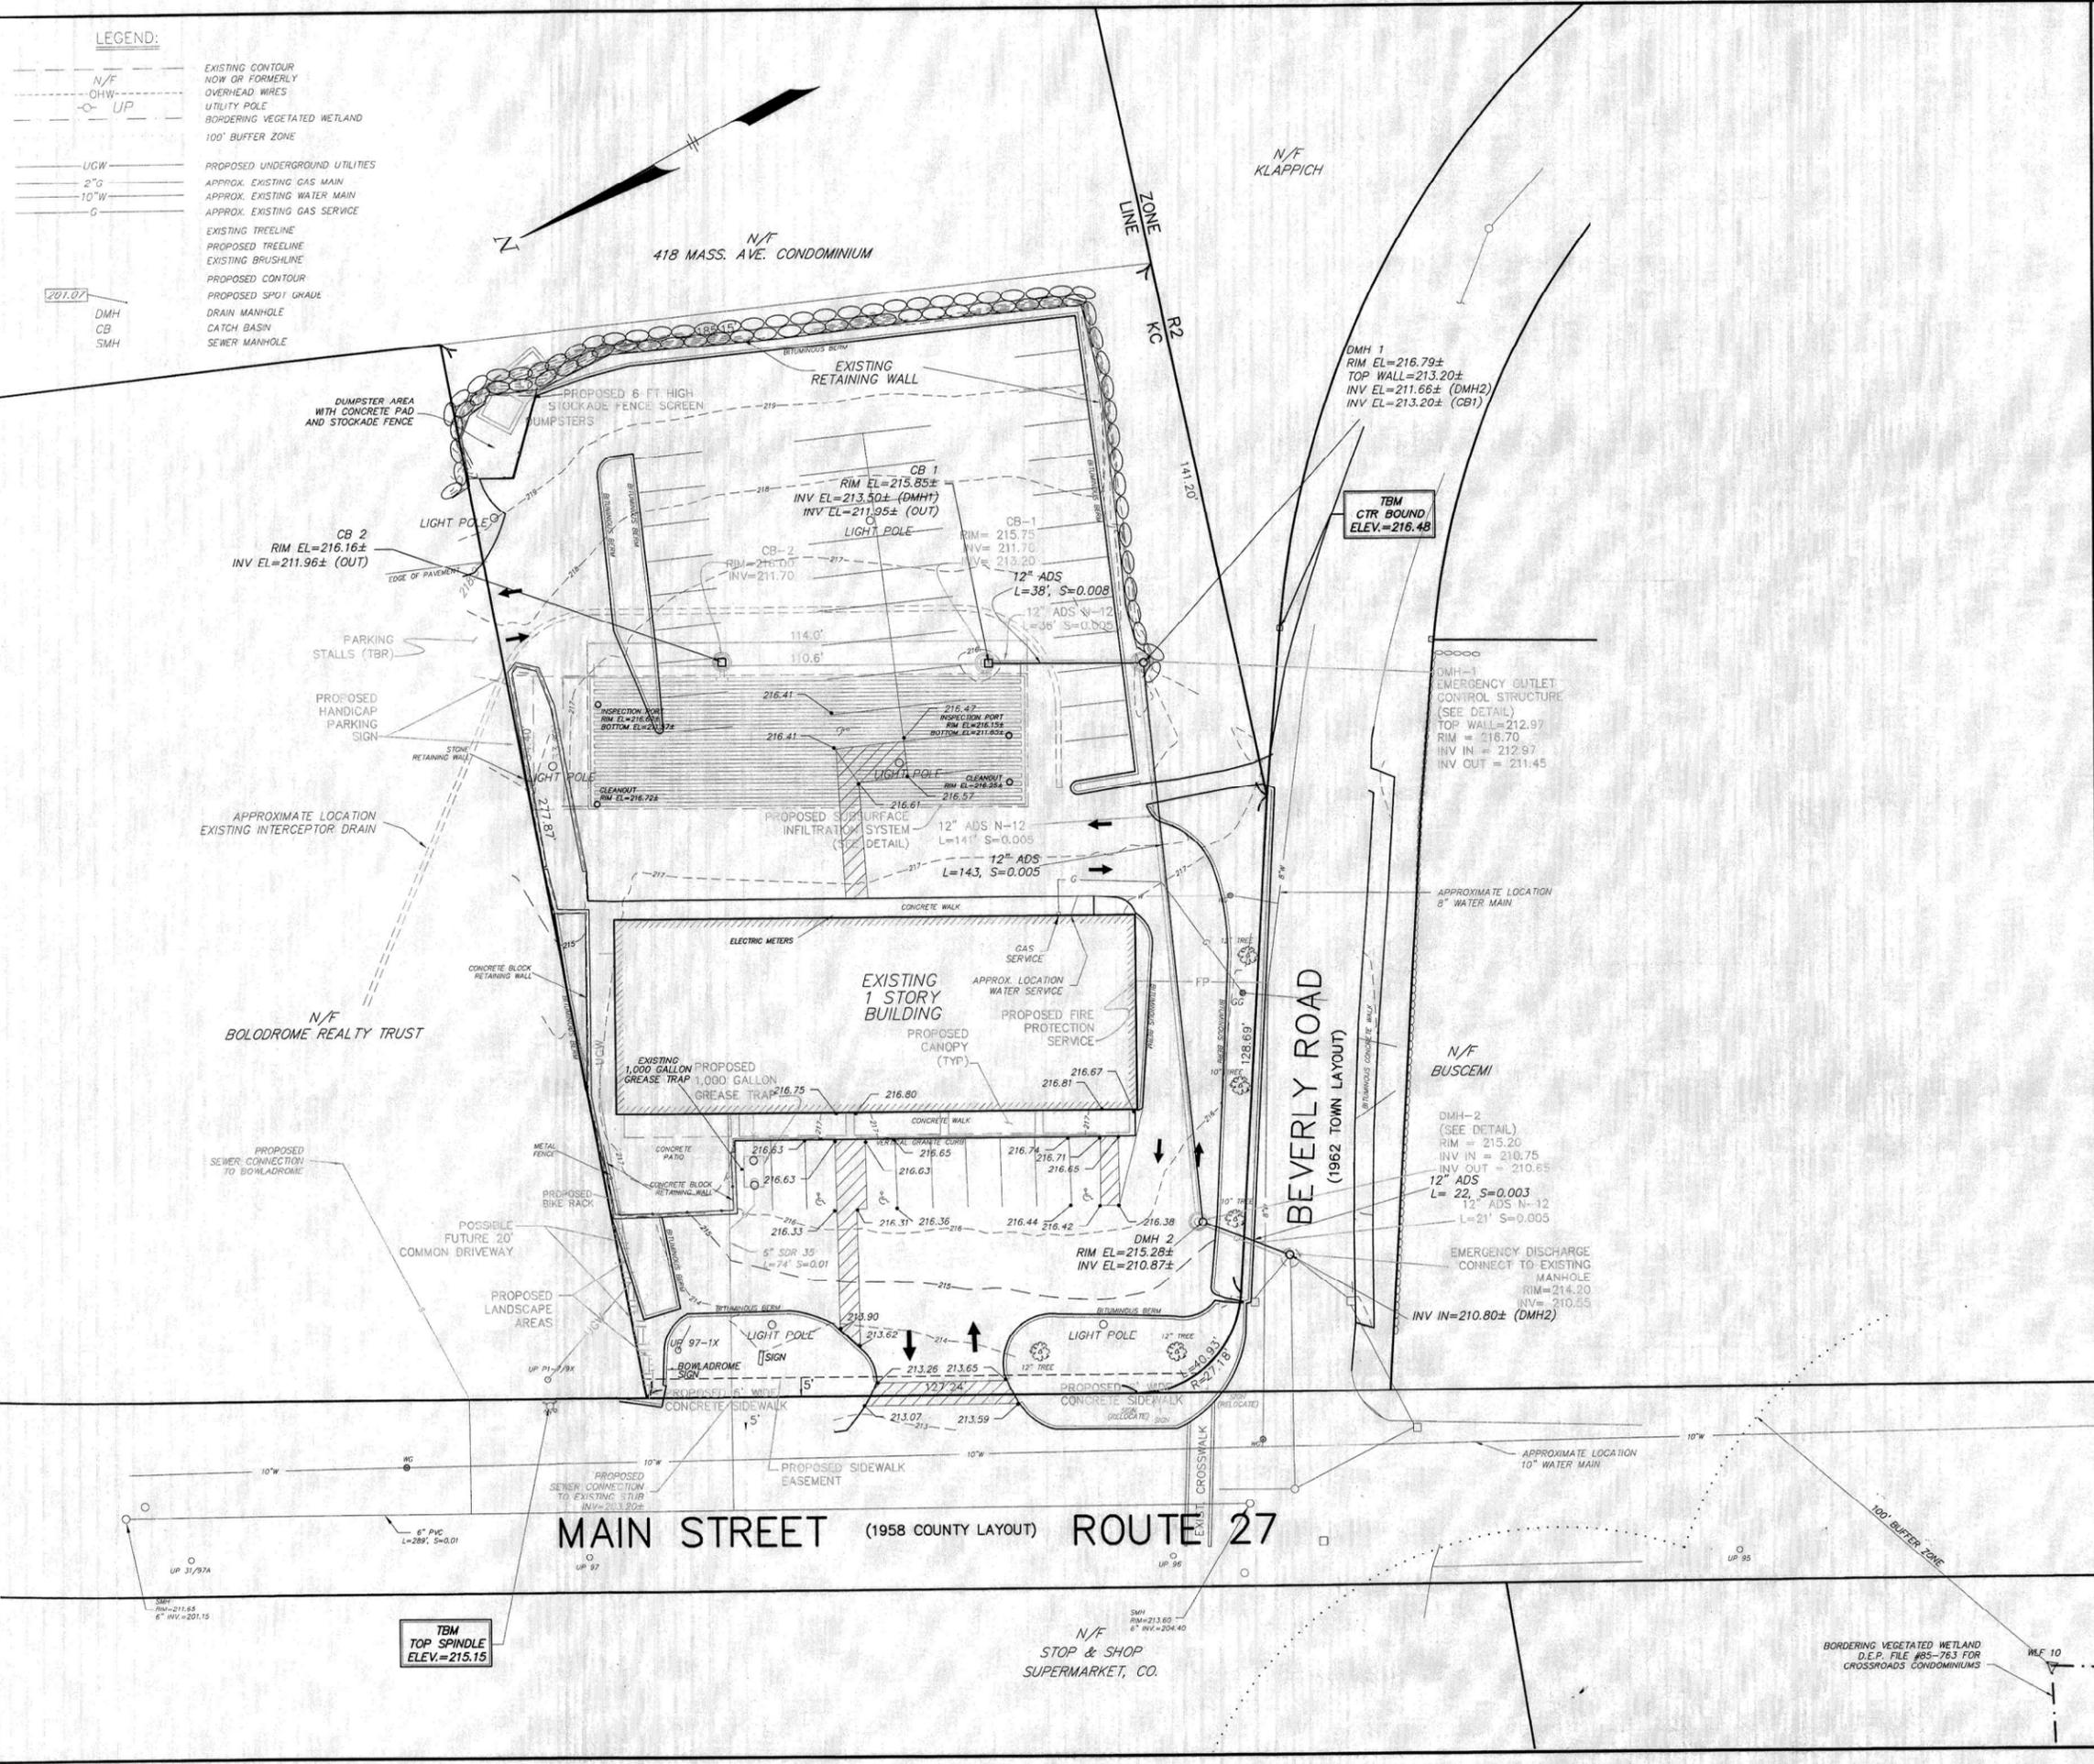

PROGRESS PRINT  
DATE 4/12/13

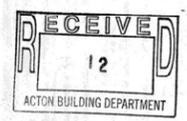

253 MAIN STREET  
AS-BUILT  
ACTON, MASSACHUSETTS

FOR: KEN SUNDBERG

SCALE: 1"=20' APRIL 12, 2013

**STAMSKI AND MCNARY, INC.**  
1000 MAIN STREET ACTON, MASSACHUSETTS  
(978) 263-8585  
ENGINEERING - PLANNING - SURVEYING

0 10 20 40 60 80 FT  
(3527 SITE D\_ASBLT.DWG) SM-3527