



**UTILITY NOTE:**  
 ALL UNDERGROUND UTILITIES SHOWN HERE WERE COMPILED ACCORDING TO AVAILABLE RECORD PLANS FROM VARIOUS UTILITY COMPANIES AND PUBLIC AGENCIES AND ARE APPROXIMATE ONLY. ACTUAL LOCATIONS MUST BE DETERMINED IN THE FIELD BEFORE DESIGNING, EXCAVATING, BLASTING, INSTALLING, BACKFILLING, GRADING, PAVEMENT RESTORATION OR REPAIRING. ALL UTILITY COMPANIES, PUBLIC AND PRIVATE, MUST BE CONTACTED INCLUDING THOSE IN CONTROL OF UTILITIES NOT SHOWN ON THIS PLAN. SEE CHAPTER 370., ACTS OF 1963 MASS. WE ASSUME NO RESPONSIBILITY FOR DAMAGES INCURRED AS A RESULT OF UTILITIES OMITTED OR INACCURATELY SHOWN. BEFORE PLANNING FUTURE CONNECTIONS, THE APPROPRIATE PUBLIC UTILITY ENGINEERING DEPARTMENT MUST BE CONSULTED. DIG SAFE TELE. NO. 1-888-344-7233.

**NOTES:**  
 1.) AS BUILT INFORMATION SHOWN IS IN COLOR.  
 2.) AS BUILT LOCATIONS AND ELEVATIONS ARE SHOWN ACCORDING TO COMPILED FIELD SURVEYS AS OF SEPTEMBER 05, 2008.

08 DEC 2008 DATE  
 MASS. REGISTERED LAND SURVEYOR

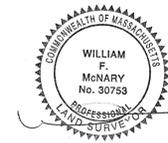

- LEGEND:**
- A.C. = AIR CONDITIONING UNIT(S)
  - BCC = BITUMINOUS CONCRETE CURB
  - BIT. = BITUMINOUS
  - B.W. = BITUMINOUS WALK
  - B.T.B.S. = BOUND TO BE SET
  - CB\DH SET = CONCRETE BOUND WITH DRILLHOLE SET
  - CB = CATCH BASIN
  - CCB = CAPE COD BERM
  - CLF = CHAIN LINK FENCE
  - C.W. = CONCRETE WALK
  - DMH = DRAIN MANHOLE
  - FENCE OR GUARD RAIL
  - GAS = GAS SERVICE
  - GG = GAS GATE VALVE
  - GM = GAS METER
  - LP = LIGHT POST
  - LW = LITTLETON WATER
  - M.N. SET = MAGNETIZED NAIL SET
  - PIV = POST INDICATOR VALVE
  - RCP = REINFORCED CONCRETE PIPE
  - RETAINING WALL
  - SEWER
  - SMH = SEWER MANHOLE
  - TELE. = TELEPHONE
  - TMH = TELEPHONE MANHOLE
  - TRANS. = TRANSFORMER
  - UGW = UTILITY POLE
  - UP = UTILITY POLE
  - W.G. = WATER GATE VALVE
  - WS = WATER SERVICE

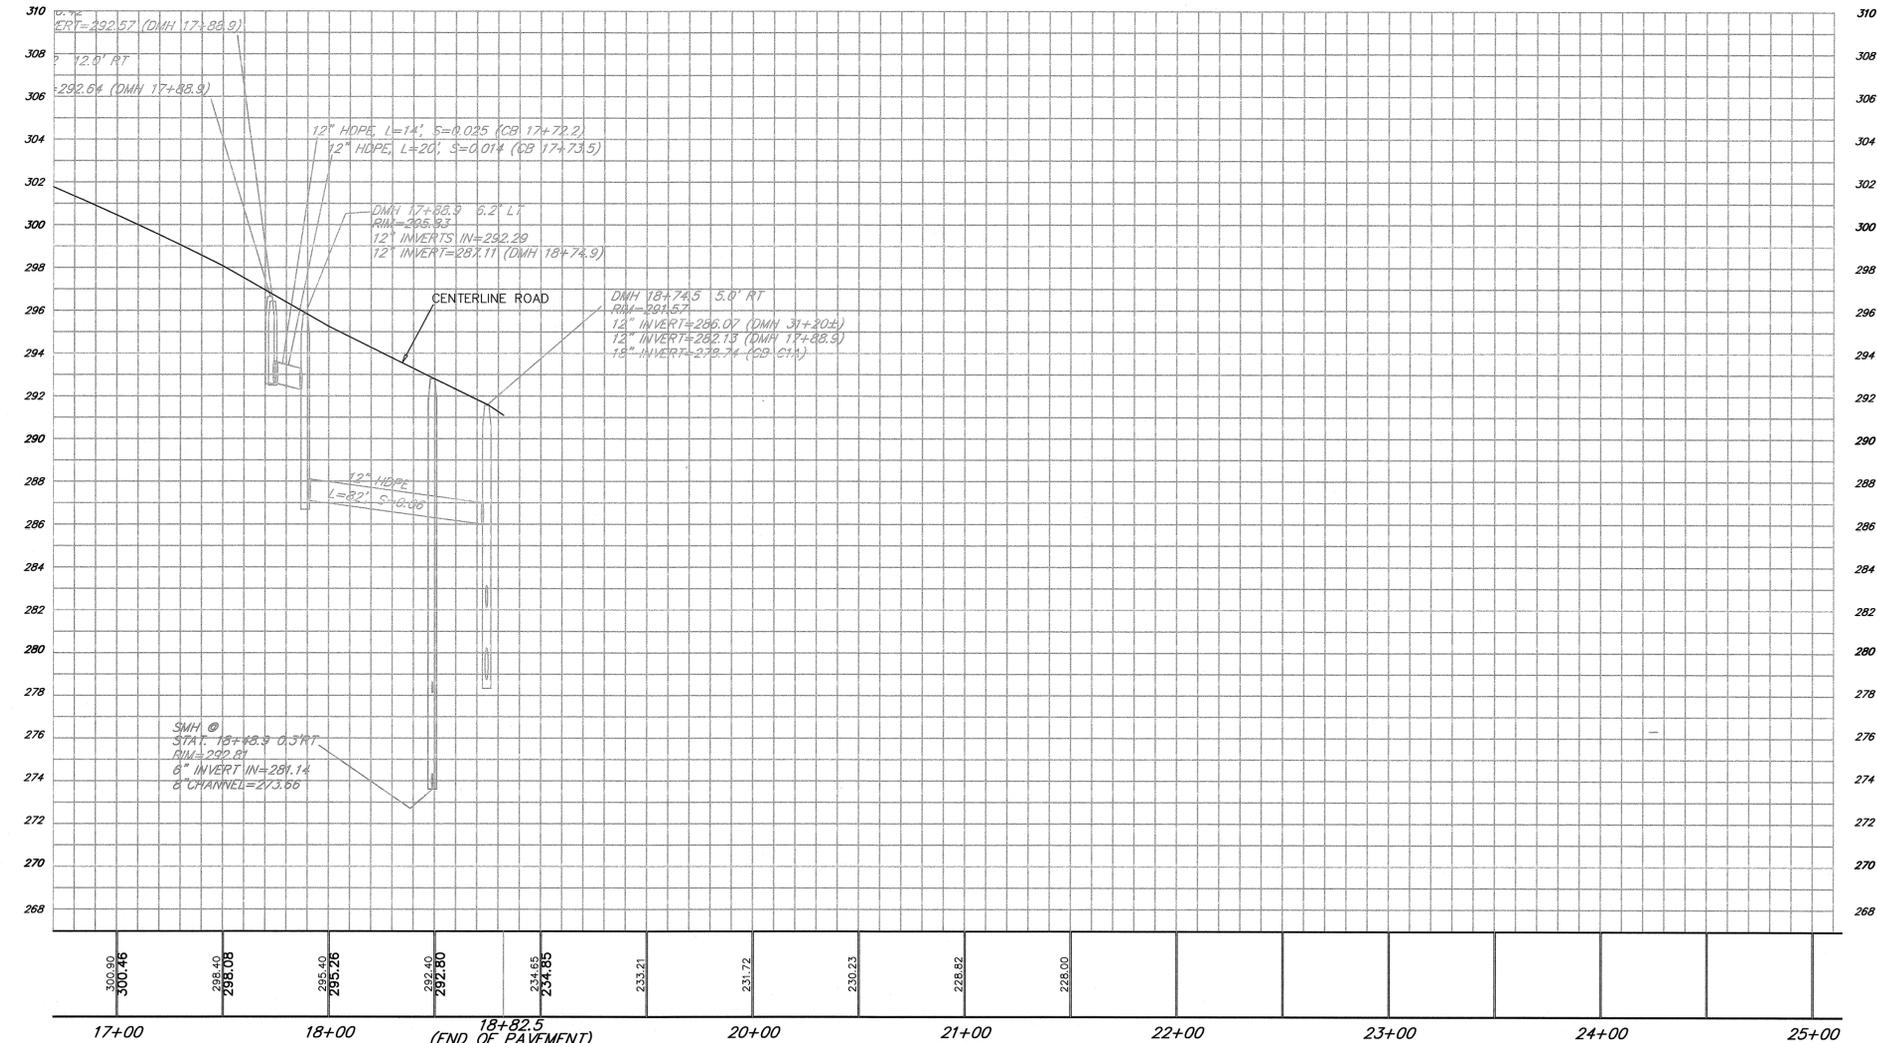

(AVALON DRIVE)  
 AS-BUILT  
 PLAN OF LAND  
 ACTON, WESTFORD &  
 LITTLETON, MASSACHUSETTS  
 (MIDDLESEX COUNTY)

FOR: AVALONBAY COMMUNITIES, INC.  
 SCALE: 1"=40' DECEMBER 8, 2008

STAMSKI AND MCNARY, INC.  
 80 HARRIS STREET ACTON, MASSACHUSETTS  
 ENGINEERING - PLANNING - SURVEYING  
 TELEPHONE No. (978) 263-8585

0 20 40 80 120 160 FT