


**UTILITY NOTE:**

ALL UNDERGROUND UTILITIES SHOWN HERE WERE COMPILED ACCORDING TO AVAILABLE RECORD PLANS FROM VARIOUS UTILITY COMPANIES AND PUBLIC AGENCIES AND ARE APPROXIMATE ONLY. ACTUAL LOCATIONS MUST BE DETERMINED IN THE FIELD BEFORE DESIGNING, EXCAVATING, BLASTING, INSTALLING, BACKFILLING, GRADING, PAVEMENT RESTORATION OR REPAIRING. ALL UTILITY COMPANIES, PUBLIC AND PRIVATE, MUST BE CONTACTED INCLUDING THOSE IN CONTROL OF UTILITIES NOT SHOWN ON THIS PLAN. SEE CHAPTER 370., ACTS OF 1963 MASS. WE ASSUME NO RESPONSIBILITY FOR DAMAGES INCURRED AS A RESULT OF UTILITIES OMITTED OR INACCURATELY SHOWN. BEFORE PLANNING FUTURE CONNECTIONS, THE APPROPRIATE PUBLIC UTILITY ENGINEERING DEPARTMENT MUST BE CONSULTED. DIG SAFE TELE. NO. 1-888-344-7233.

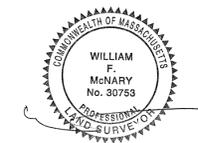


**NOTES:**

- 1.) AS BUILT INFORMATION SHOWN IS IN COLOR.
- 2.) AS BUILT LOCATIONS AND ELEVATIONS ARE SHOWN ACCORDING TO COMPILED FIELD SURVEYS AS OF SEPTEMBER 05, 2008.

08 DEC 2008  
DATE MASS. REGISTERED LAND SURVEYOR

**LEGEND:**

- A.C. = AIR CONDITIONING UNIT(S)
- BCC = BITUMINOUS CONCRETE CURB
- BIT. = BITUMINOUS
- B.W. = BITUMINOUS WALK
- B.T.B.S. = BOUND TO BE SET
- CB\DH SET = CONCRETE BOUND WITH DRILLHOLE SET
- CB = CATCH BASIN
- CCB = CAPE COD BERM
- CLF = CHAIN LINK FENCE
- C.W. = CONCRETE WALK
- DMH = DRAIN MANHOLE
- FENCE OR GUARD RAIL
- GAS = GAS SERVICE
- CG = GAS GATE VALVE
- GM = GAS METER
- LP = LIGHT POST
- LW = LITTLETON WATER
- M.N. SET = MAGNETIZED NAIL SET
- PIV = POST INDICATOR VALVE
- RCP = REINFORCED CONCRETE PIPE
- RETAINING WALL
- SEWER
- SMH = SEWER MANHOLE
- TELE. = TELEPHONE
- TMH = TELEPHONE MANHOLE
- TRANS. = TRANSFORMER
- UGW = TELEPHONE OR ELECTRIC
- UP = UTILITY POLE
- W.G. = WATER GATE VALVE
- WS = WATER SERVICE

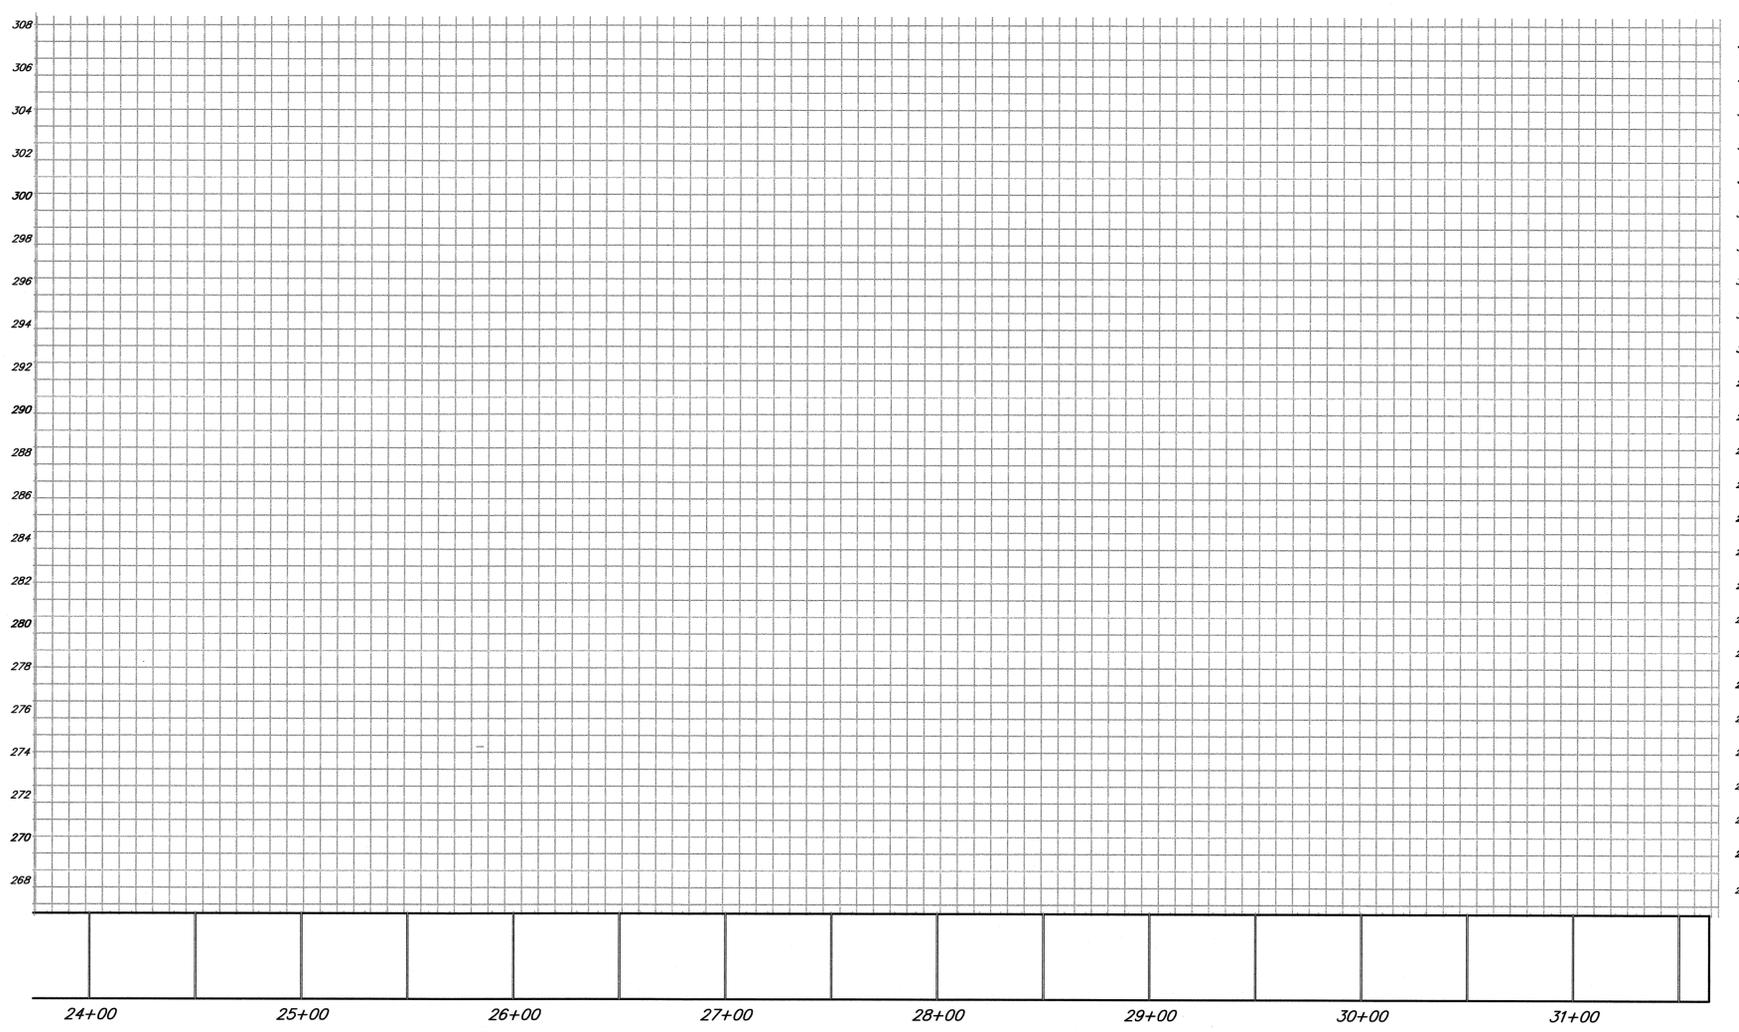

(AVALON DRIVE)  
AS-BUILT  
PLAN OF LAND  
**ACTON, WESTFORD &  
LITTLETON, MASSACHUSETTS**  
(MIDDLESEX COUNTY)

FOR: AVALONBAY COMMUNITIES, INC.  
SCALE: 1"=40' DECEMBER 8, 2008

**STAMSKI AND McNARY, INC.**  
80 HARRIS STREET ACTON, MASSACHUSETTS  
ENGINEERING - PLANNING - SURVEYING  
TELEPHONE No. (978) 263-8585

