



Massachusetts Department of Environmental Protection
Bureau of Resource Protection - Wetlands

WPA Form 8A – Request for Certificate of Compliance

Massachusetts Wetlands Protection Act M.G.L. c. 131, §40

DEP File Number:

85-1081

Provided by DEP

A. Project Information

Important:
When filling out forms on the computer, use only the tab key to move your cursor - do not use the return key.



Upon completion of the work authorized in an Order of Conditions, the property owner must request a Certificate of Compliance from the issuing authority stating that the work or portion of the work has been satisfactorily completed.

1. This request is being made by:

Town of Concord Department of Public Works

Name

135 Keyes Road


Mailing Address

Concord

City/Town

978-318-3250

Phone Number

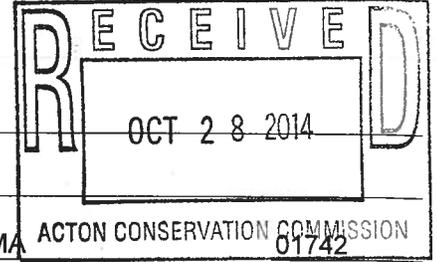

MA
State

01742
Zip Code

2. This request is in reference to work regulated by a final Order of Conditions issued to:

Town of Concord Department of Public Works

Applicant

2/15/2012

Dated

85-1081

DEP File Number

3. The project site is located at:

339 Nagog Hill Road

Street Address

C-4

Assessors Map/Plat Number

Acton

City/Town

14

Parcel/Lot Number

4. The final Order of Conditions was recorded at the Registry of Deeds for:

Property Owner (if different)

Middlesex

County

58645

Book

394

Page

Certificate (if registered land)

5. This request is for certification that (check one):

the work regulated by the above-referenced Order of Conditions has been satisfactorily completed.

the following portions of the work regulated by the above-referenced Order of Conditions have been satisfactorily completed (use additional paper if necessary).

the above-referenced Order of Conditions has lapsed and is therefore no longer valid, and the work regulated by it was never started.



A. Project Information (cont.)

6. Did the Order of Conditions for this project, or the portion of the project subject to this request, contain an approval of any plans stamped by a registered professional engineer, architect, landscape architect, or land surveyor?

Yes If yes, attach a written statement by such a professional certifying substantial compliance with the plans and describing what deviation, if any, exists from the plans approved in the Order.

No


B. Submittal Requirements

Requests for Certificates of Compliance should be directed to the issuing authority that issued the final Order of Conditions (OOC). If the project received an OOC from the Conservation Commission, submit this request to that Commission. If the project was issued a Superseding Order of Conditions or was the subject of an Adjudicatory Hearing Final Decision, submit this request to the appropriate DEP Regional Office (see <http://www.mass.gov/eea/agencies/massdep/about/contacts/find-the-massdep-regional-office-for-your-city-or-town.html>).

October 27, 2014

Acton Conservation Commission
472 Main Street
Acton, MA 01720

Re: **Nagog Pond Dam Repairs**
Request for Certificate of Compliance
DEP File No. 85-1081
PARE Project No. 10122.01

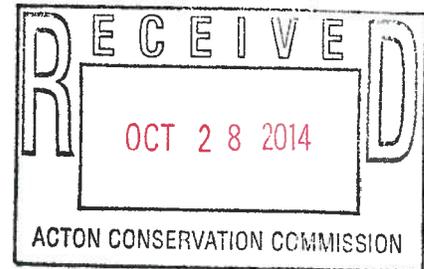

Dear Commission Members:

Based upon a review of site conditions in the Summer of 2013, the work at the Nagog Pond Dam project in Acton, Massachusetts is currently considered complete with all work satisfactorily completed and suitable stands of grass restored in areas disturbed by construction activities. The work was completed in accordance with the project specifications and Order of Conditions issued for the work.

Construction work was generally completed in accordance with the Contract Documents. However, some revisions to the original plans were incorporated as part of the work including: 1) Raising the elevation of the culvert downstream of the primary spillway due to shallow bedrock; 2) Modifying the configuration of the low level outlet approach channel due to the identification of an existing bedrock channel encountered during construction; and, 3) Revisions to the extent of abandonment of existing valves in the gatehouse.

We trust that this letter and attached documentation provides sufficient information for the Commission to find that the project has satisfactorily been completed in accordance with the Order of Conditions issued for the work and to issue a Certificate of Compliance. Should you have any questions or require any additional information please do not hesitate to contact us at 508.543.1755 or by email at aorsi@parecorp.com.

Sincerely,

PARE CORPORATION








Allen R. Orsi, P.E.
Managing Engineer

Attachments

WPA Form 8a – Request for Certificate of Compliance
Sheet 3: Dam Improvements Plan and Sections [with as-built survey data]
As Built Drawings (Contractor Redlines)

Cc: William Renault, Town of Concord

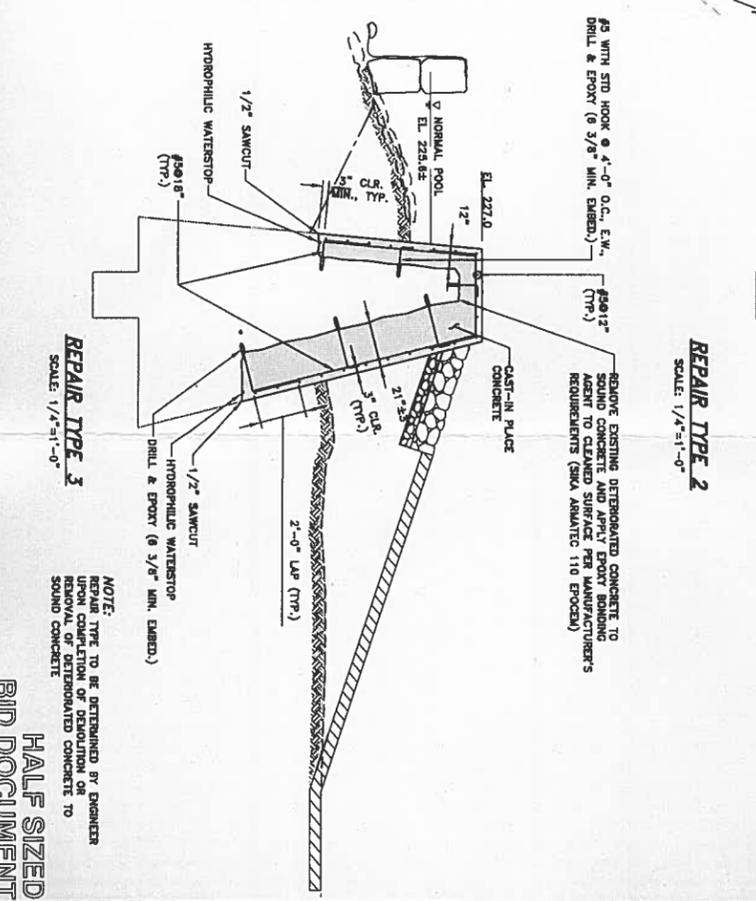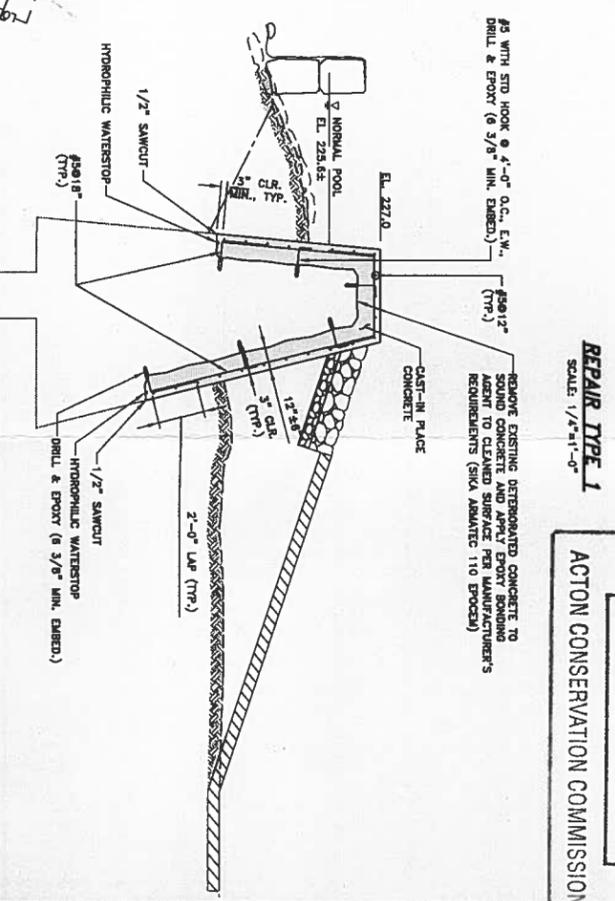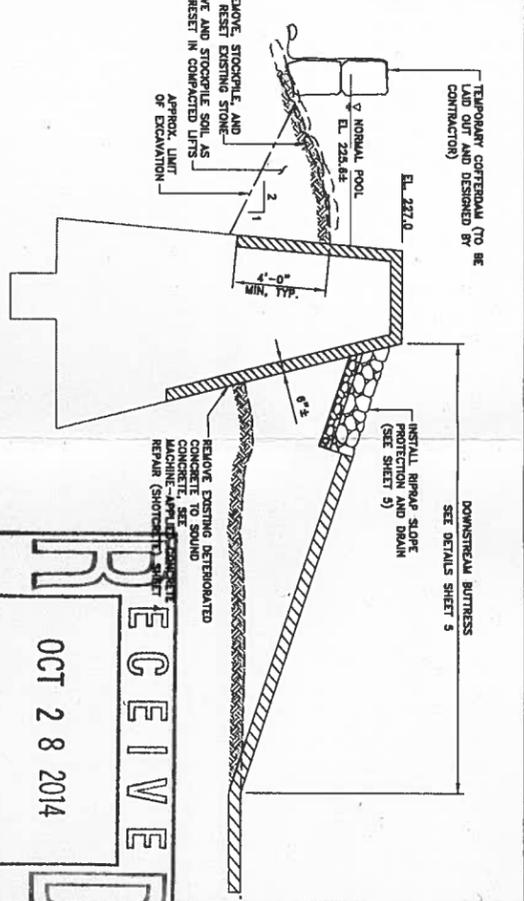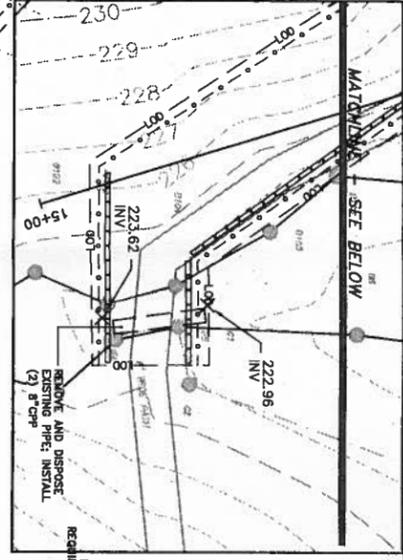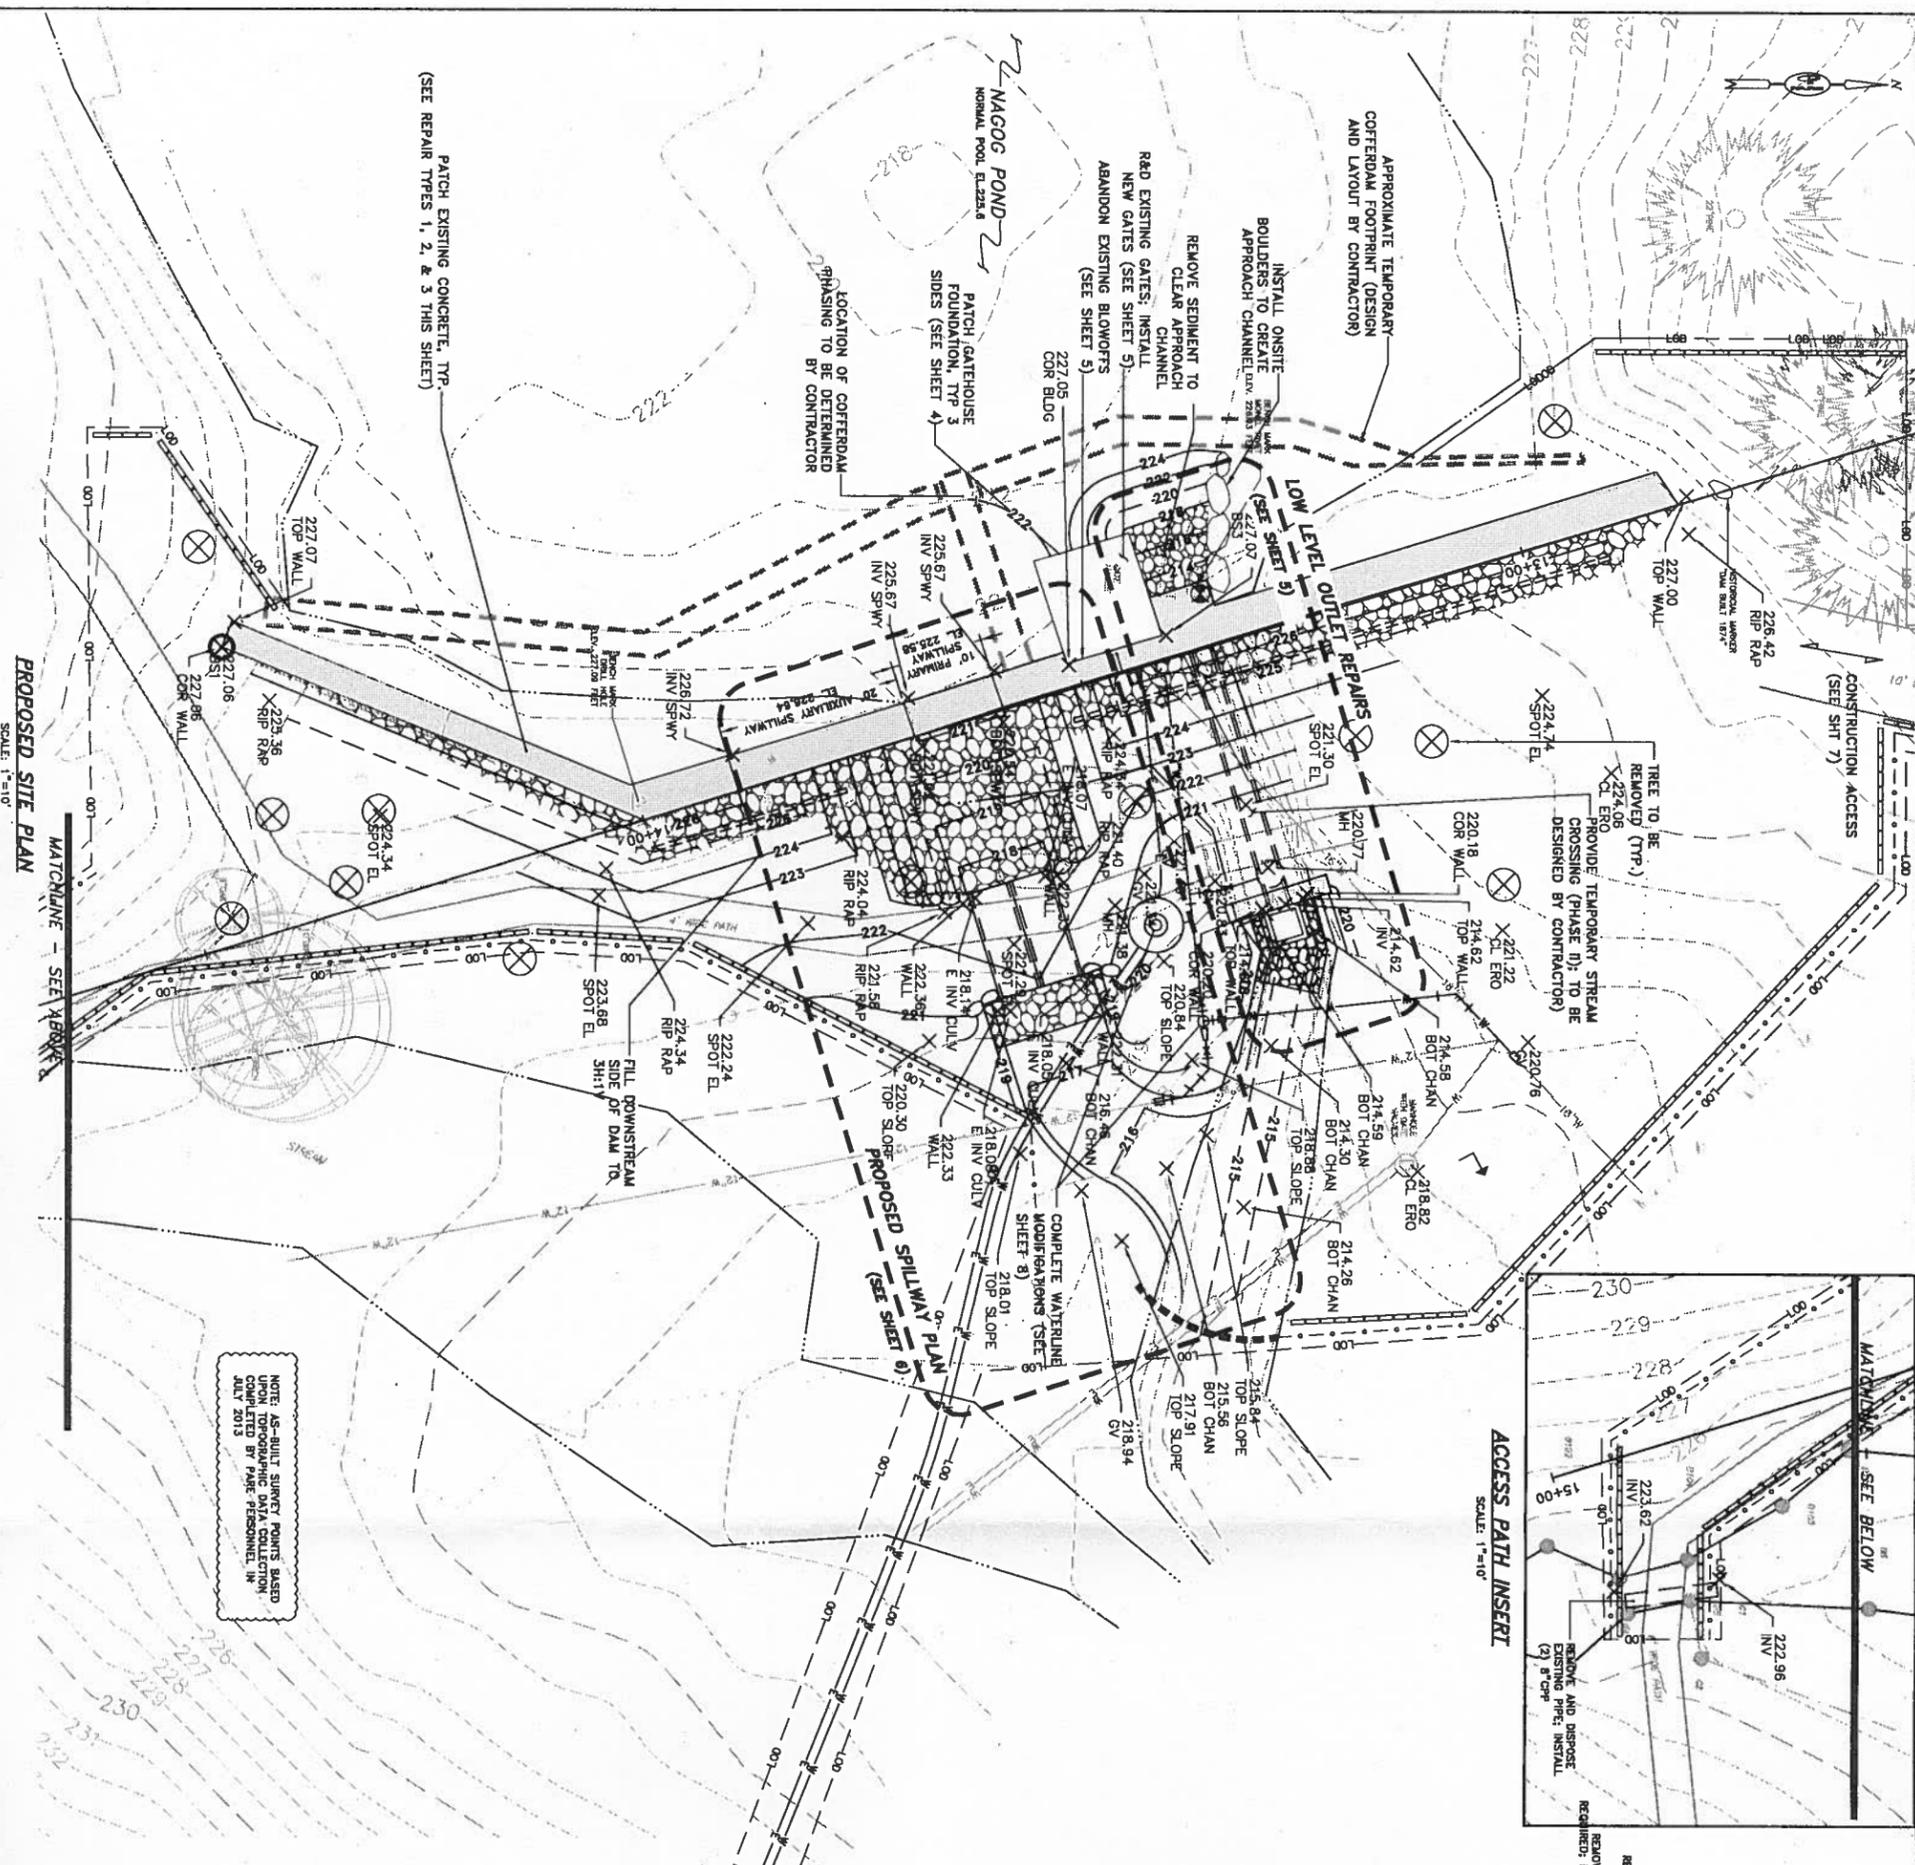

RECEIVED
 OCT 28 2014
 ACTON CONSERVATION COMMISSION

NAGOG POND DAM REPAIRS
 MA00129 / 4-9-2-5
 ACTON, MASSACHUSETTS
 TOWN OF CONCORD

PARE CORPORATION
 ENGINEERS - SCIENTISTS - PLANNERS
 10 LINDSAY DRIVE, SUITE 100
 WILMINGTON, MA 01897
 508-543-1755

SCALE ADJUSTMENT
 GUIDE
 0' 1' 2'

REVISIONS:	AS-BUILT	PROJECT NO.:	1022201
1	7/2013	DATE:	MAY 2012
	FORM DATA	SCALE:	AS NOTED
		DESIGNED BY:	KWC / AND
		CHECKED BY:	JHG / AND
		DRAWN BY:	JHG / JMB
		APPROVED BY:	JMB

DAM IMPROVEMENTS
 PLAN AND SECTIONS
 SHEET NO.: **3**

PROPOSED SITE PLAN
 SCALE: 1"=310'
 MATCHLINE - SEE SHEET 8

NOTE: AS-BUILT SURVEY POINTS BASED UPON TOPOGRAPHIC DATA COLLECTION COMPLETED BY PARE PERSONNEL IN JULY 2013

PATCH EXISTING CONCRETE, TYP.
 (SEE REPAIR TYPES 1, 2, & 3 THIS SHEET)

LOCATION OF COFFERDAM
 PHASING TO BE DETERMINED
 BY CONTRACTOR

PATCH GATEHOUSE
 FOUNDATION, TYP 3
 SIDES (SEE SHEET 4)

REMOVE SEDIMENT TO
 CLEAR APPROACH
 CHANNEL
 R&D EXISTING GATES; INSTALL
 NEW GATES (SEE SHEET 5)
 ABANDON EXISTING BLOWOFFS
 (SEE SHEET 5)

APPROXIMATE TEMPORARY
 COFFERDAM FOOTPRINT (DESIGN
 AND LAYOUT BY CONTRACTOR)

TREE TO BE
 REMOVED (TYP.)
 PROVIDE TEMPORARY STREAM
 CROSSING (PHASE II); TO BE
 DESIGNED BY CONTRACTOR

CONSTRUCTION ACCESS
 (SEE SH 7)

FILL DOWNSTREAM
 SIDE OF DAM TO
 PROPOSED SPILLWAY PLAN

COMPLETE WATERLOG
 MODIFICATIONS (SEE
 SHEET 8)

ACCESS PATH INSERT
 SCALE: 1"=10'

REPAIR TYPE 1
 SCALE: 1/2"=1'-0"

REPAIR TYPE 2
 SCALE: 1/2"=1'-0"

REPAIR TYPE 3
 SCALE: 1/2"=1'-0"

NOTE: TYPE TO BE DETERMINED BY ENGINEER
 UPON COMPLETION OF DEMOLITION OR
 REMOVAL OF DETRIMENTATED CONCRETE TO
 SOUND CONCRETE