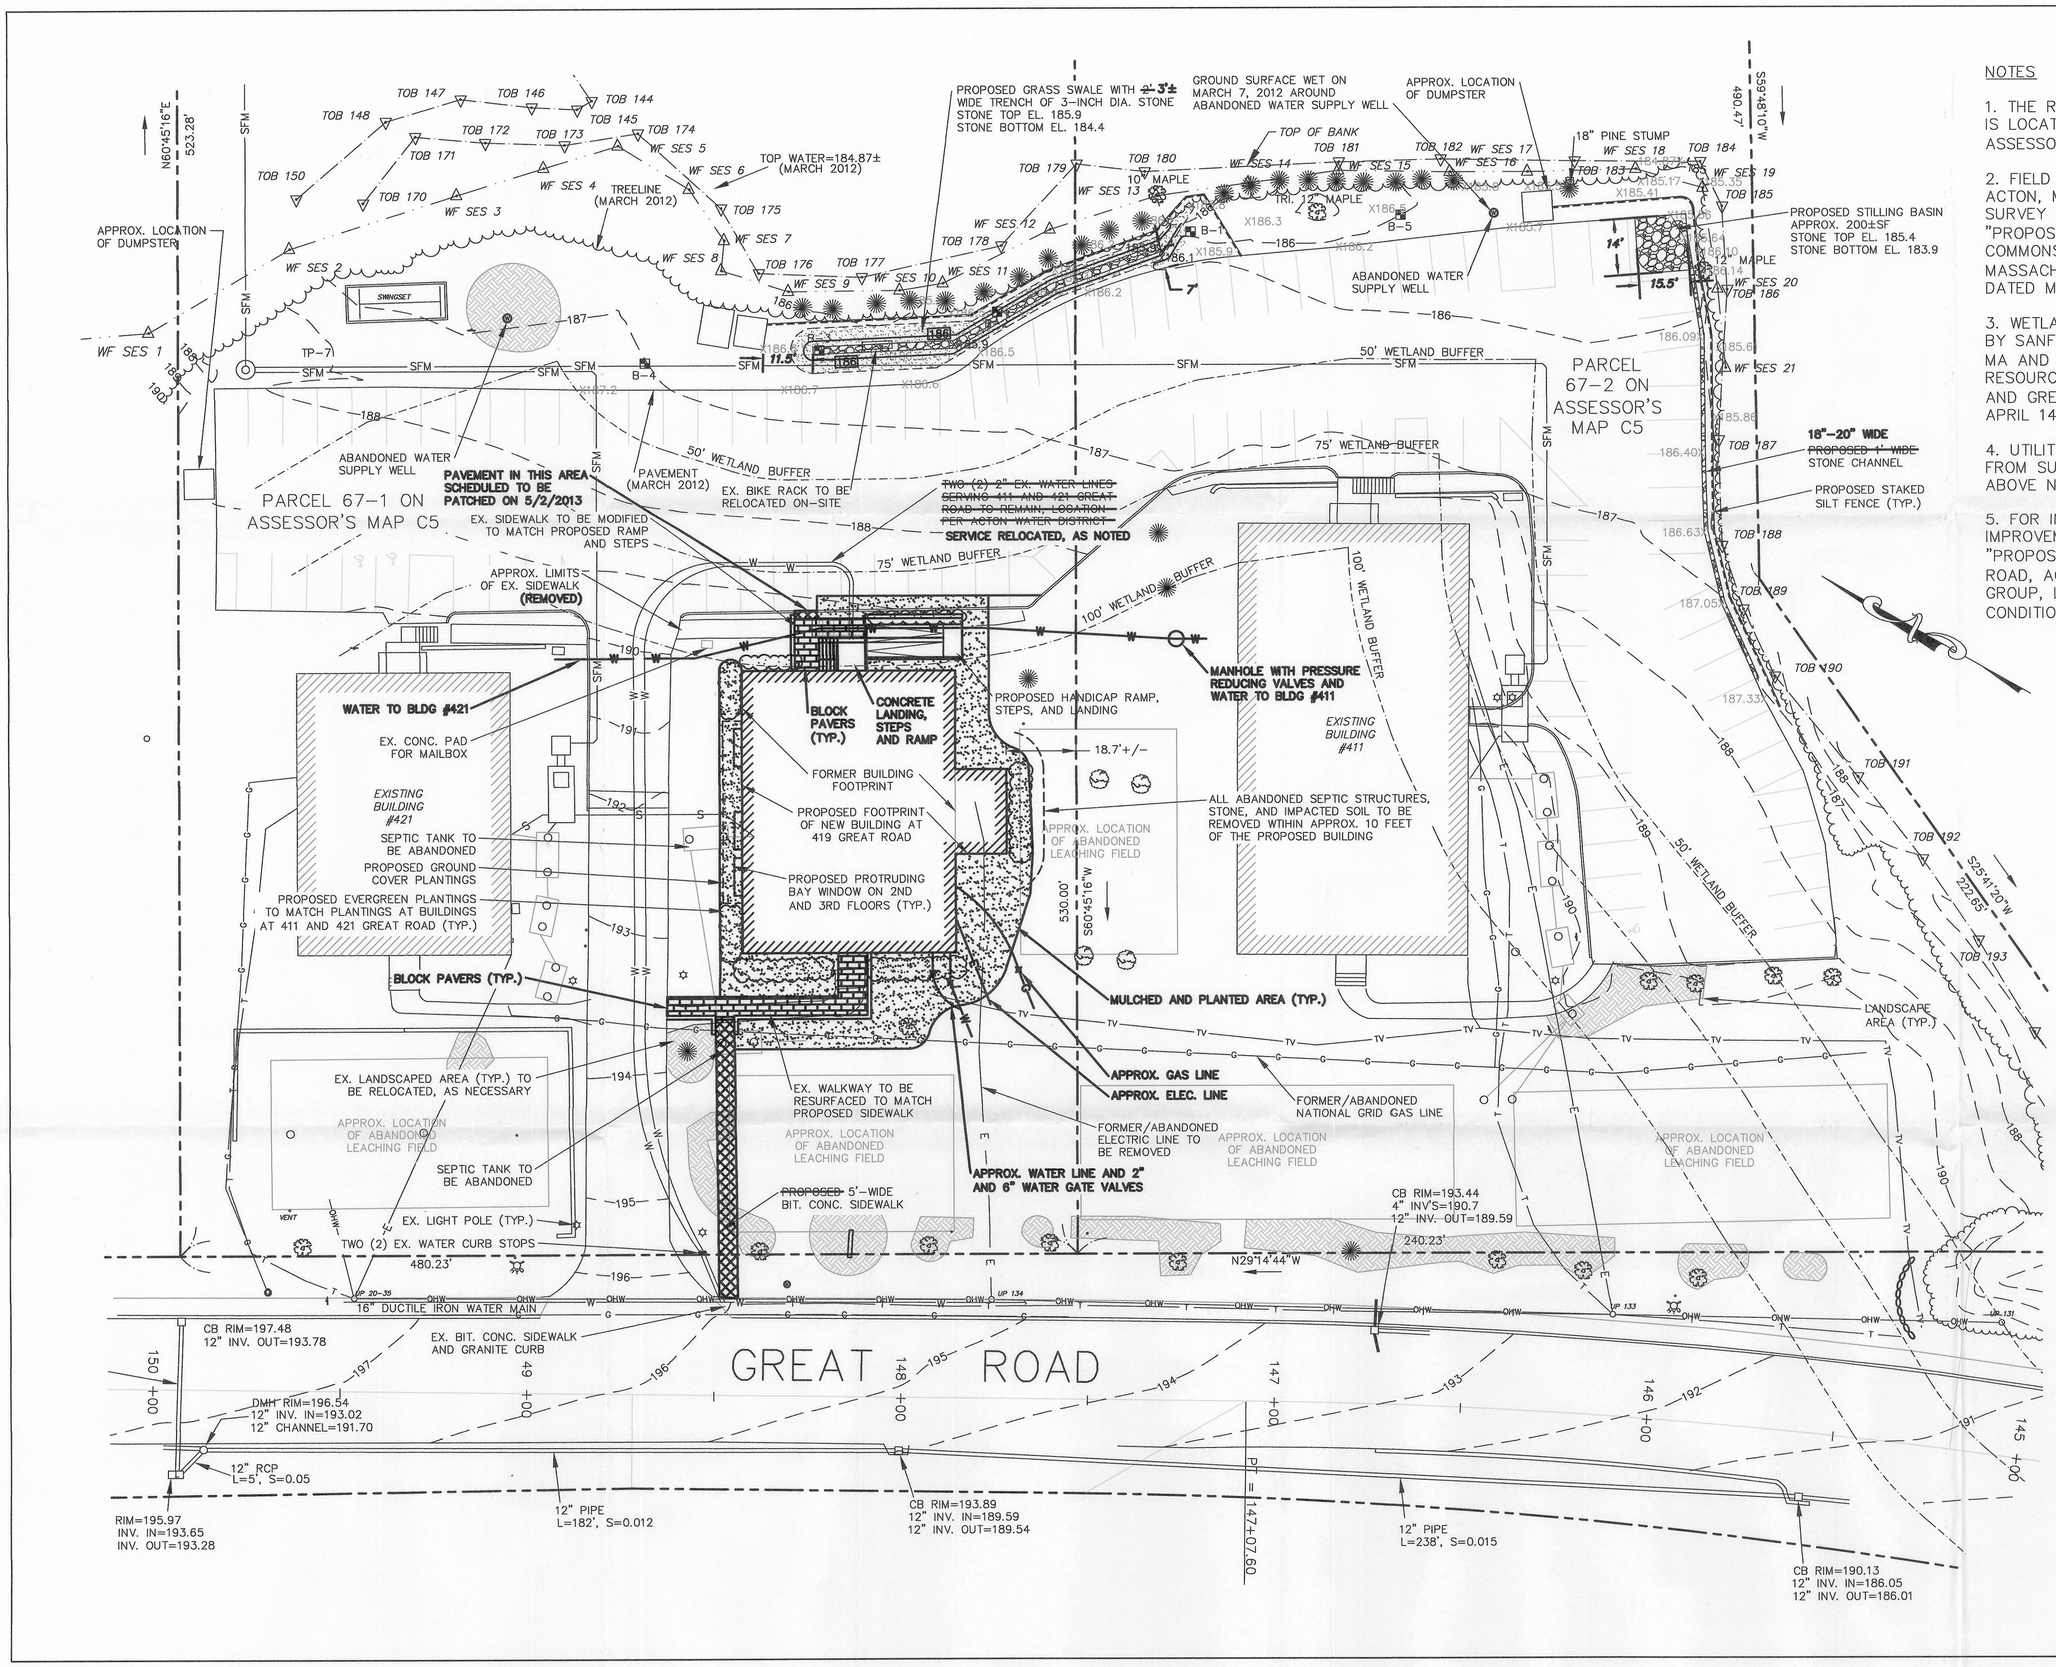

NOTES

1. THE RESIDENTIAL APARTMENT BUILDING AT 419 GREAT ROAD IS LOCATED ON PARCEL 67-1 OF THE TOWN OF ACTON ASSESSOR'S MAP C5.

2. FIELD SURVEY COMPLETED BY STAMSKI AND MCNARY, INC. OF ACTON, MA IN 2005, 2006, AND MARCH 2012. FOR ADDITIONAL SURVEY INFORMATION, REFER TO SET OF PLANS ENTITLED "PROPOSED WASTEWATER TREATMENT FACILITY, SPRING HILL COMMONS, HARRIS STREET AND GREAT ROAD, ACTON, MASSACHUSETTS" PREPARED BY NORFOLK RAM GROUP, LLC AND DATED MAY 2006.

3. WETLAND RESOURCE AREAS WERE DELINEATED WITH FLAGS BY SANFORD ECOLOGICAL SERVICES, INC. OF SOUTHBOROUGH, MA AND DESCRIBED IN THE REPORT ENTITLED "WETLANDS RESOURCE REPORT, SPRING HILL COMMONS, OFF HARRIS STREET AND GREAT ROAD (RTE. 2A), ACTON, MASSACHUSETTS" DATED APRIL 14, 2006.

4. UTILITIES SHOWN HEREON ARE APPROXIMATE AND COMPILED FROM SURVEYS FROM 2005 AND 2006 MENTIONED IN THE ABOVE NOTE 2.

5. FOR INFORMATION ON THE PROPOSED STORMWATER IMPROVEMENTS SHOWN HEREON, REFER TO PLAN ENTITLED "PROPOSED STORMWATER IMPROVEMENTS, 411 & 419 GREAT ROAD, ACTON, MASSACHUSETTS" PREPARED BY NORFOLK RAM GROUP, LLC AND STAMPED MAY 21, 2012 AND THE ORDER OF CONDITIONS ISSUED JUNE 6, 2012 (DEP FILE NO. 85-1093).

AS-BUILT NOTES

1. AS-BUILT INFORMATION SHOWN HEREON WAS COMPILED FROM NOTES, SWING TIES AND SKETCHES PROVIDED BY THE CONTRACTOR, SCOTT BURNHAM OF BURNHAM CONSTRUCTION COMPANY, INC., DURING A SITE VISIT ON MAY 1, 2013.

2. NO INSPECTION OF THE CONSTRUCTION OF THE UNDERGROUND UTILITIES WAS PERFORMED BY NORFOLK RAM GROUP, LLC.

3. DISTURBED EARTH AREAS WERE HYDRO-SEEDED ON MAY 1, 2013.

REVISIONS

Date	By	Description
5/2/2013	K.M.K.	AS-BUILT INFO

Designed by:	K.M.K.	Scale:	1" = 20'
Drawn by:	K.M.K.		
Checked by:	K.P.K.	Date:	06/20/2012
Approved by:	K.P.K.		

PREPARED FOR: UNIVERSAL MANAGEMENT
181 WELLS AVENUE
NEWTON, MASSACHUSETTS 02459

~~PROPOSED~~ AS-BUILT RECONSTRUCTION SITE PLAN
419 GREAT ROAD
ACTON, MASSACHUSETTS

NORFOLK·RAM
ENGINEERING SOLUTIONS FOR THE ENVIRONMENT
ONE ROBERTS ROAD, PLYMOUTH, MA 02360
PHONE: (508)747-7900 FAX: (508)747-3758
WWW.NORFOLKRAM.COM

SHEET 1 OF 1

PROJ. 1466.1.1