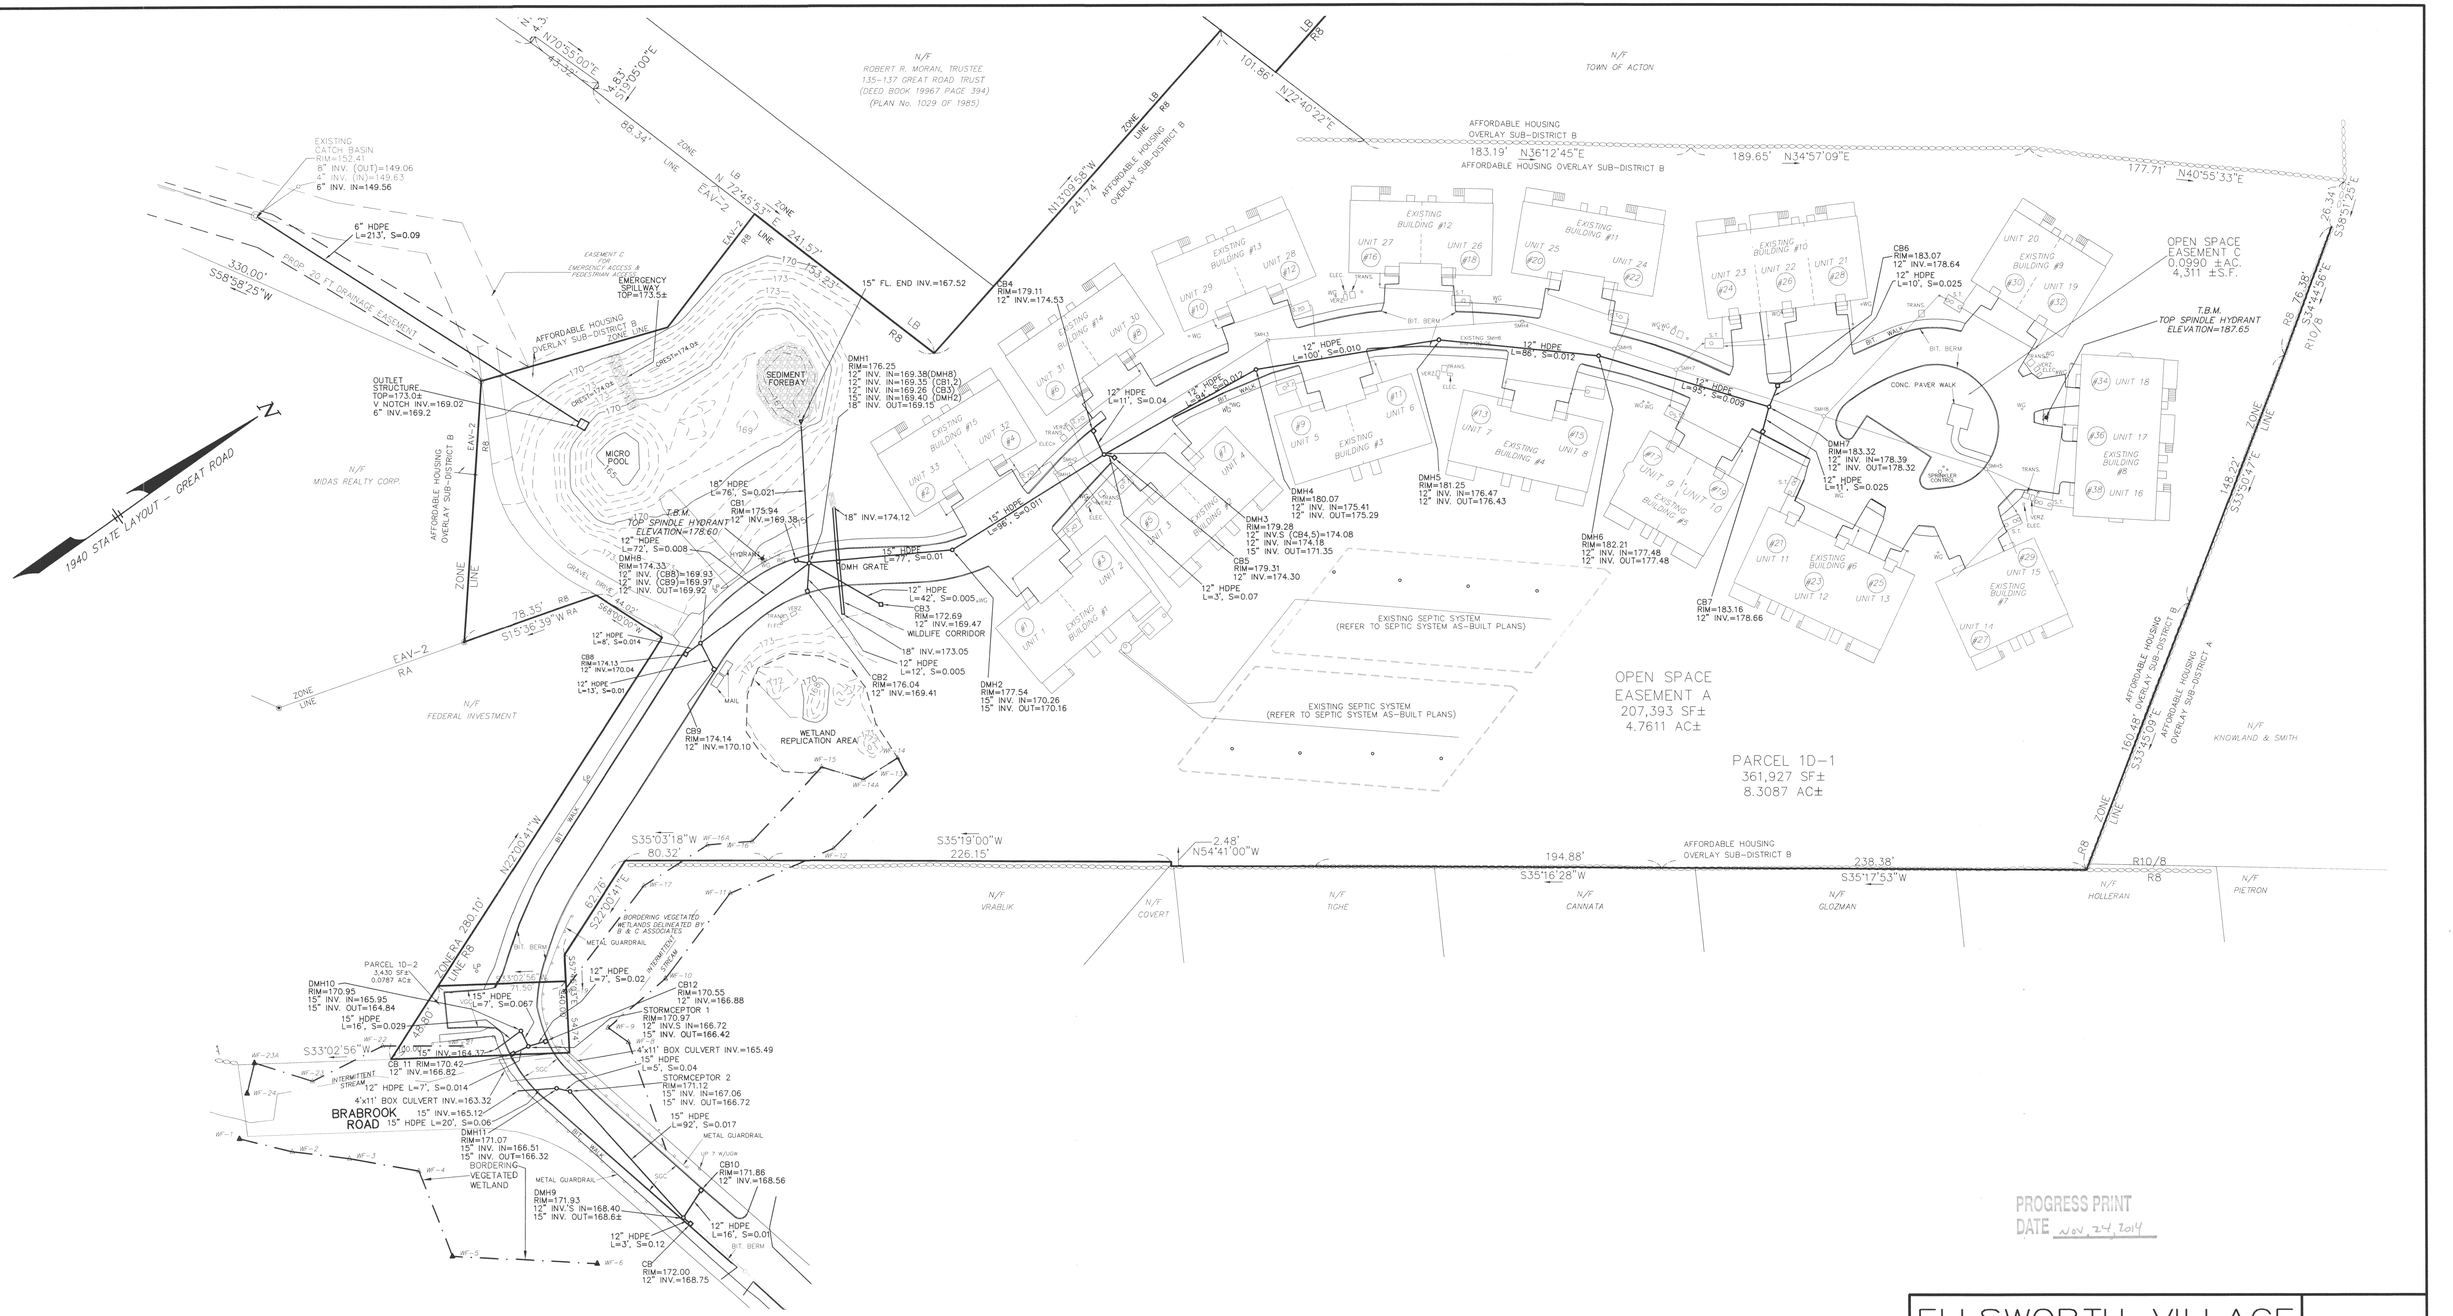


## LEGEND:

- EXISTING DRAIN LINE
- EXISTING OVERHEAD WIRES
- EXISTING UTILITY POLE
- N/F NOW OR FORMERLY
- EDGE OF BORDERING VEGETATED WETLANDS
- WETLAND FLAG
- S.T. SEPTIC TANK
- SMH SEWER MANHOLE
- LP. LIGHT POLE
- BIT. BERM BITUMINOUS BERM
- SGC SLOPED GRANITE CURB
- VGC VERTICAL GRANITE CURB
- LP. LIGHT POLE
- EXISTING STONEWALL
- WG WATER GATE
- TRANS. TRANSFORMER
- ELEC. ELECTRIC
- VERZ. VERIZON
- D.H. DRILL HOLE
- FND. FOUND
- LB LIMITED BUSINESS DISTRICT
- RB RESIDENCE B DISTRICT
- R10/8 RESIDENCE 10/8 DISTRICT
- RA RESIDENCE A DISTRICT

## UTILITY NOTE

ALL UNDERGROUND UTILITIES SHOWN HERE WERE COMPILED ACCORDING TO AVAILABLE RECORD PLANS FROM VARIOUS UTILITY COMPANIES AND PUBLIC AGENCIES AND ARE APPROXIMATE ONLY. ACTUAL LOCATIONS MUST BE DETERMINED IN THE FIELD BEFORE DESIGNING, EXCAVATING, BLASTING, INSTALLING, BACKFILLING, GRADING, PAVEMENT RESTORATION OR REPAIRING. ALL UTILITY COMPANIES, PUBLIC AND PRIVATE, MUST BE CONTACTED INCLUDING THOSE IN CONTROL OF UTILITIES NOT SHOWN ON THIS PLAN. SEE CHAPTER 370, ACTS OF 1963 MASS. WE ASSUME NO RESPONSIBILITY FOR DAMAGE INCURRED AS A RESULT OF UTILITIES OMITTED OR INACCURATELY SHOWN. BEFORE PLANNING FUTURE CONNECTIONS, THE APPROPRIATE PUBLIC UTILITY ENGINEERING DEPARTMENT MUST BE CONSULTED. DIG-SAFE TELE. NO. (888) 344-7233.

PROGRESS PRINT
DATE NOV. 24, 2014

# ELLSWORTH VILLAGE
# ACTON, MASSACHUSETTS

SITE AS-BUILT PLAN
FOR: ELLSWORTH VILLAGE, LLC
SCALE: 1"=40' MAY 1, 2014


STAMSKI AND MCNARY, INC.
1000 MAIN STREET ACTON, MASS.
*ENGINEERING - PLANNING - SURVEYING*


0 20 40 80 120 160 FT

SM-2768 (2768 ASBLT SITED.DWG)