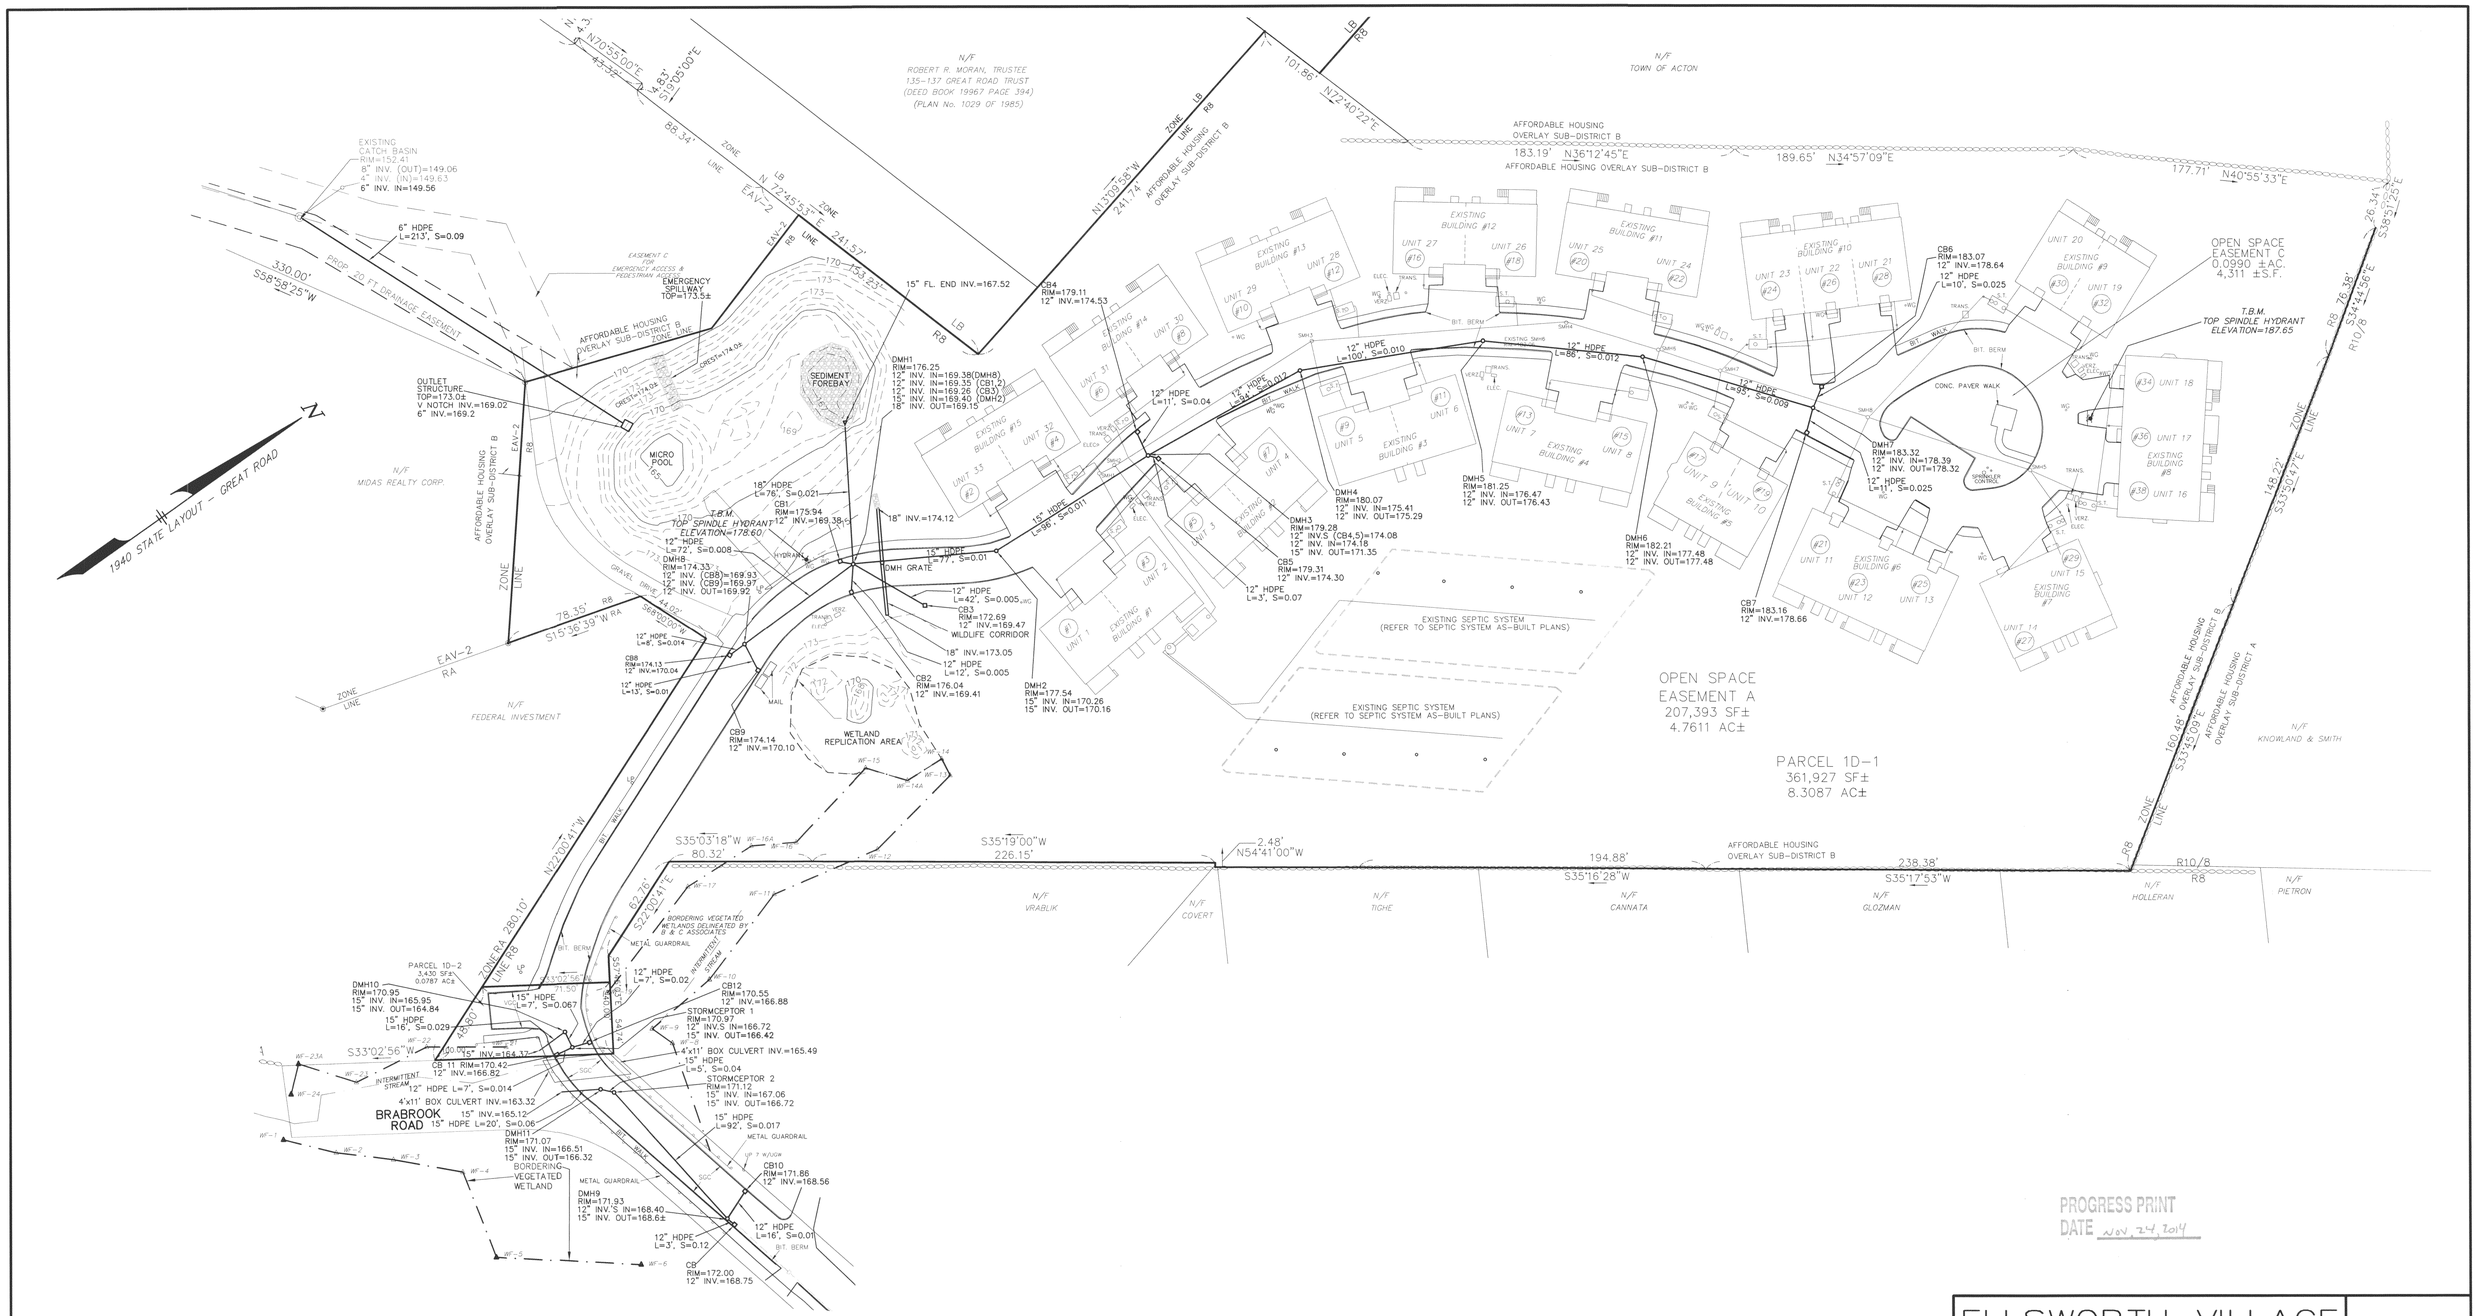

PROGRESS PRINT
DATE NOV. 24, 2014

LEGEND:

— — — D — — —	EXISTING DRAIN LINE
——— OHW ———	EXISTING OVERHEAD WIRES
UP116/B	EXISTING UTILITY POLE
N/F	NOW OR FORMERLY
	EDGE OF BORDERING VEGETATED WETLANDS
A WF-8	WETLAND FLAG
S.T.	SEPTIC TANK
SMH	SEWER MANHOLE
LP	LIGHT POLE
BIT. BERM	BITUMINOUS BERM
SGC	SLOPED GRANITE CURB
VGC	VERTICAL GRANITE CURB
LP	LIGHT POLE
	EXISTING STONEWALL
WG	WATER GATE
TRANS.	TRANSFORMER
ELEC	ELECTRIC
VERZ	VERIZION
D.H.	DRILL HOLE
FND.	FOUND
LB	LIMITED BUSINESS DISTRICT
R8	RESIDENCE 8 DISTRICT
R10/8	RESIDENCE 10/8 DISTRICT
RA	RESIDENCE A DISTRICT

UTILITY NOTE

ALL UNDERGROUND UTILITIES SHOWN HERE WERE COMPILED ACCORDING TO AVAILABLE RECORD PLANS FROM VARIOUS UTILITY COMPANIES AND PUBLIC AGENCIES AND ARE APPROXIMATE ONLY. ACTUAL LOCATIONS MUST BE DETERMINED IN THE FIELD BEFORE DESIGNING, EXCAVATING, BLASTING, INSTALLING, BACKFILLING, GRADING, PAVEMENT RESTORATION OR REPAIRING. ALL UTILITY COMPANIES, PUBLIC AND PRIVATE, MUST BE CONTACTED INCLUDING THOSE IN CONTROL OF UTILITIES NOT SHOWN ON THIS PLAN. SEE CHAPTER 370, ACTS OF 1963 MASS. WE ASSUME NO RESPONSIBILITY FOR DAMAGE INCURRED AS A RESULT OF UTILITIES OMITTED OR INACCURATELY SHOWN. BEFORE PLANNING FUTURE CONNECTIONS, THE APPROPRIATE PUBLIC UTILITY ENGINEERING DEPARTMENT MUST BE CONSULTED. DIG-SAFE TELE. NO. (888) 344-7233.

ELLSWORTH VILLAGE
ACTON, MASSACHUSETTS

SITE AS-BUILT PLAN

FOR: ELLSWORTH VILLAGE, LLC

SCALE: 1"=40' MAY 1, 2014

STAMSKI AND MCNARY, INC.
1000 MAIN STREET ACTON, MASS.
ENGINEERING – PLANNING – SURVEYING

0 20 40 80 120 160 FT

SM-2768 (2768 ASBLT SITED.DWG)