BALED HAY EROSION CHART

EROSION CHECKS CONSISTING OF STAKED HAY BALES SHALL BE INSTALLED TO PREVENT SILTATION DOWNGRADE OF CONSTRUCTION. HAY BALES WILL BE STAKED & INSTALLED AS RECOMMENDED IN THE SOIL CONSERVATION SERVICE GUIDELINES FOR SOIL AND WATER CONSERVATION IN URBANIZING AREAS OF MASSACHUSETTS, AS SHOWN BELOW.

TYPICAL HAY BALE CONSTRUCTION DETAIL

NO SCALE

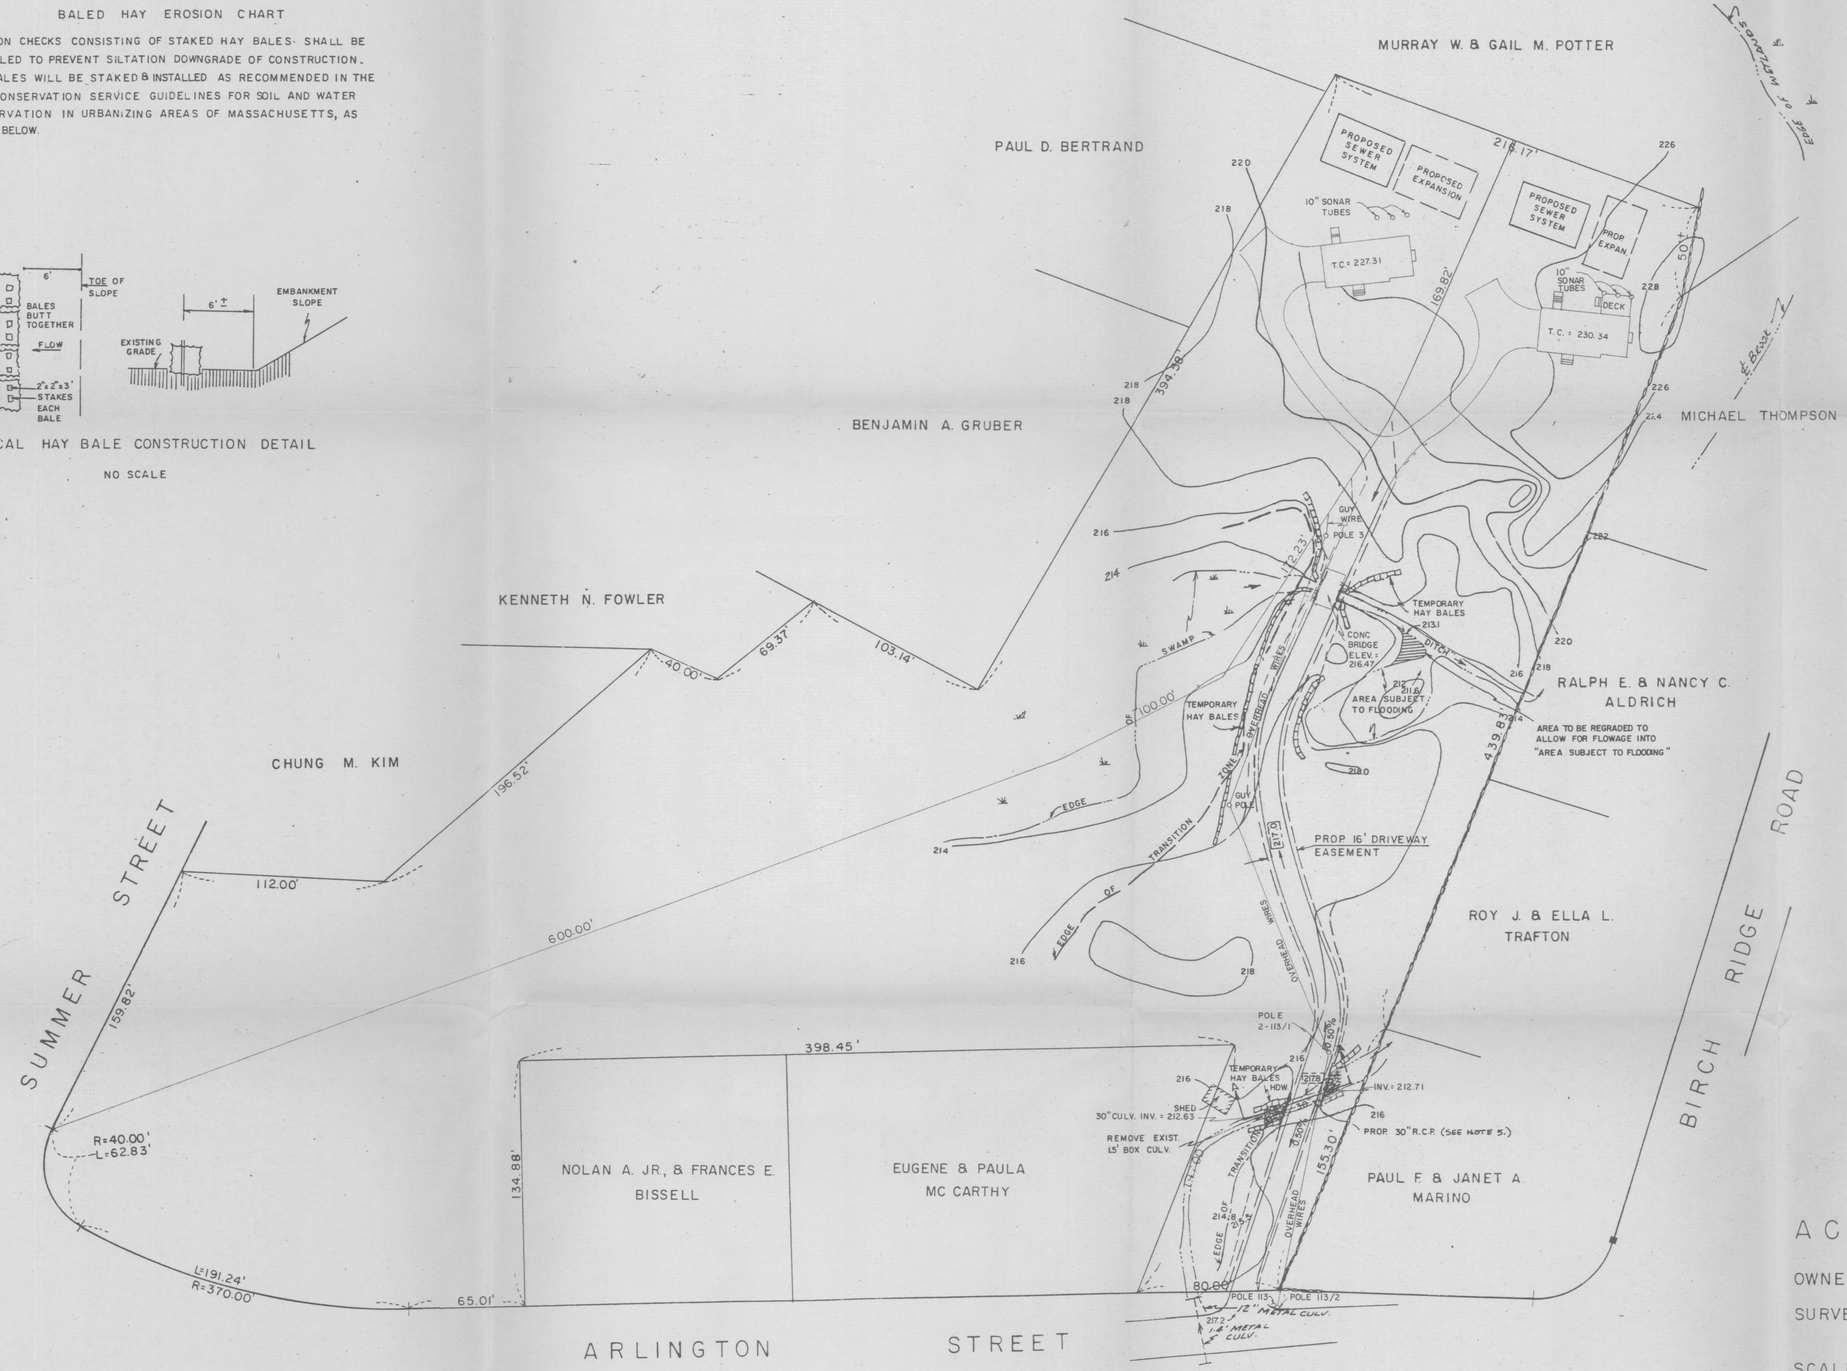

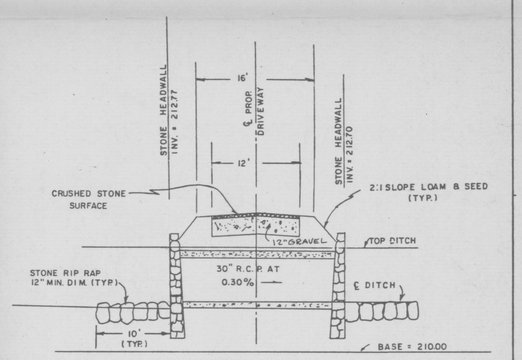

SECTION A-A

1" = 10' HORIZ.
1" = 4' VERT.

NOTES

1. —— INDICATES EXISTING CONTOURS
2. --- INDICATES PROPOSED CONTOURS
3. 200.0 INDICATES PROPOSED ELEVATIONS
4. DATUM: U.S.C. & G.S.
5. PIPE SIZE REVISED FROM 48" TO 30" AS PER ACTON CONSERVATION COMMISSION ORDER OF CONDITIONS.

WETLAND AS-BUILT

IN

ACTON, MASS.

OWNED BY: PAUL F. & JANET A. MARINO

SURVEY & PLAN BY: COLBURN ENGINEERING, INC.
454 MAIN STREET, HUDSON, MASS.

SCALE: 1" = 40' APRIL 17, 1986

COMMONWEALTH OF MASSACHUSETTS CARLTON B. COLBURN, JR. No. 23327 REGISTERED LAND SURVEYOR

Carlton B. Colburn Jr.

0 20 40 80 120
SCALE OF THIS PLAN

COMMONWEALTH OF MASSACHUSETTS CARLTON B. COLBURN, JR. REGISTERED PROFESSIONAL ENGINEER

840-A