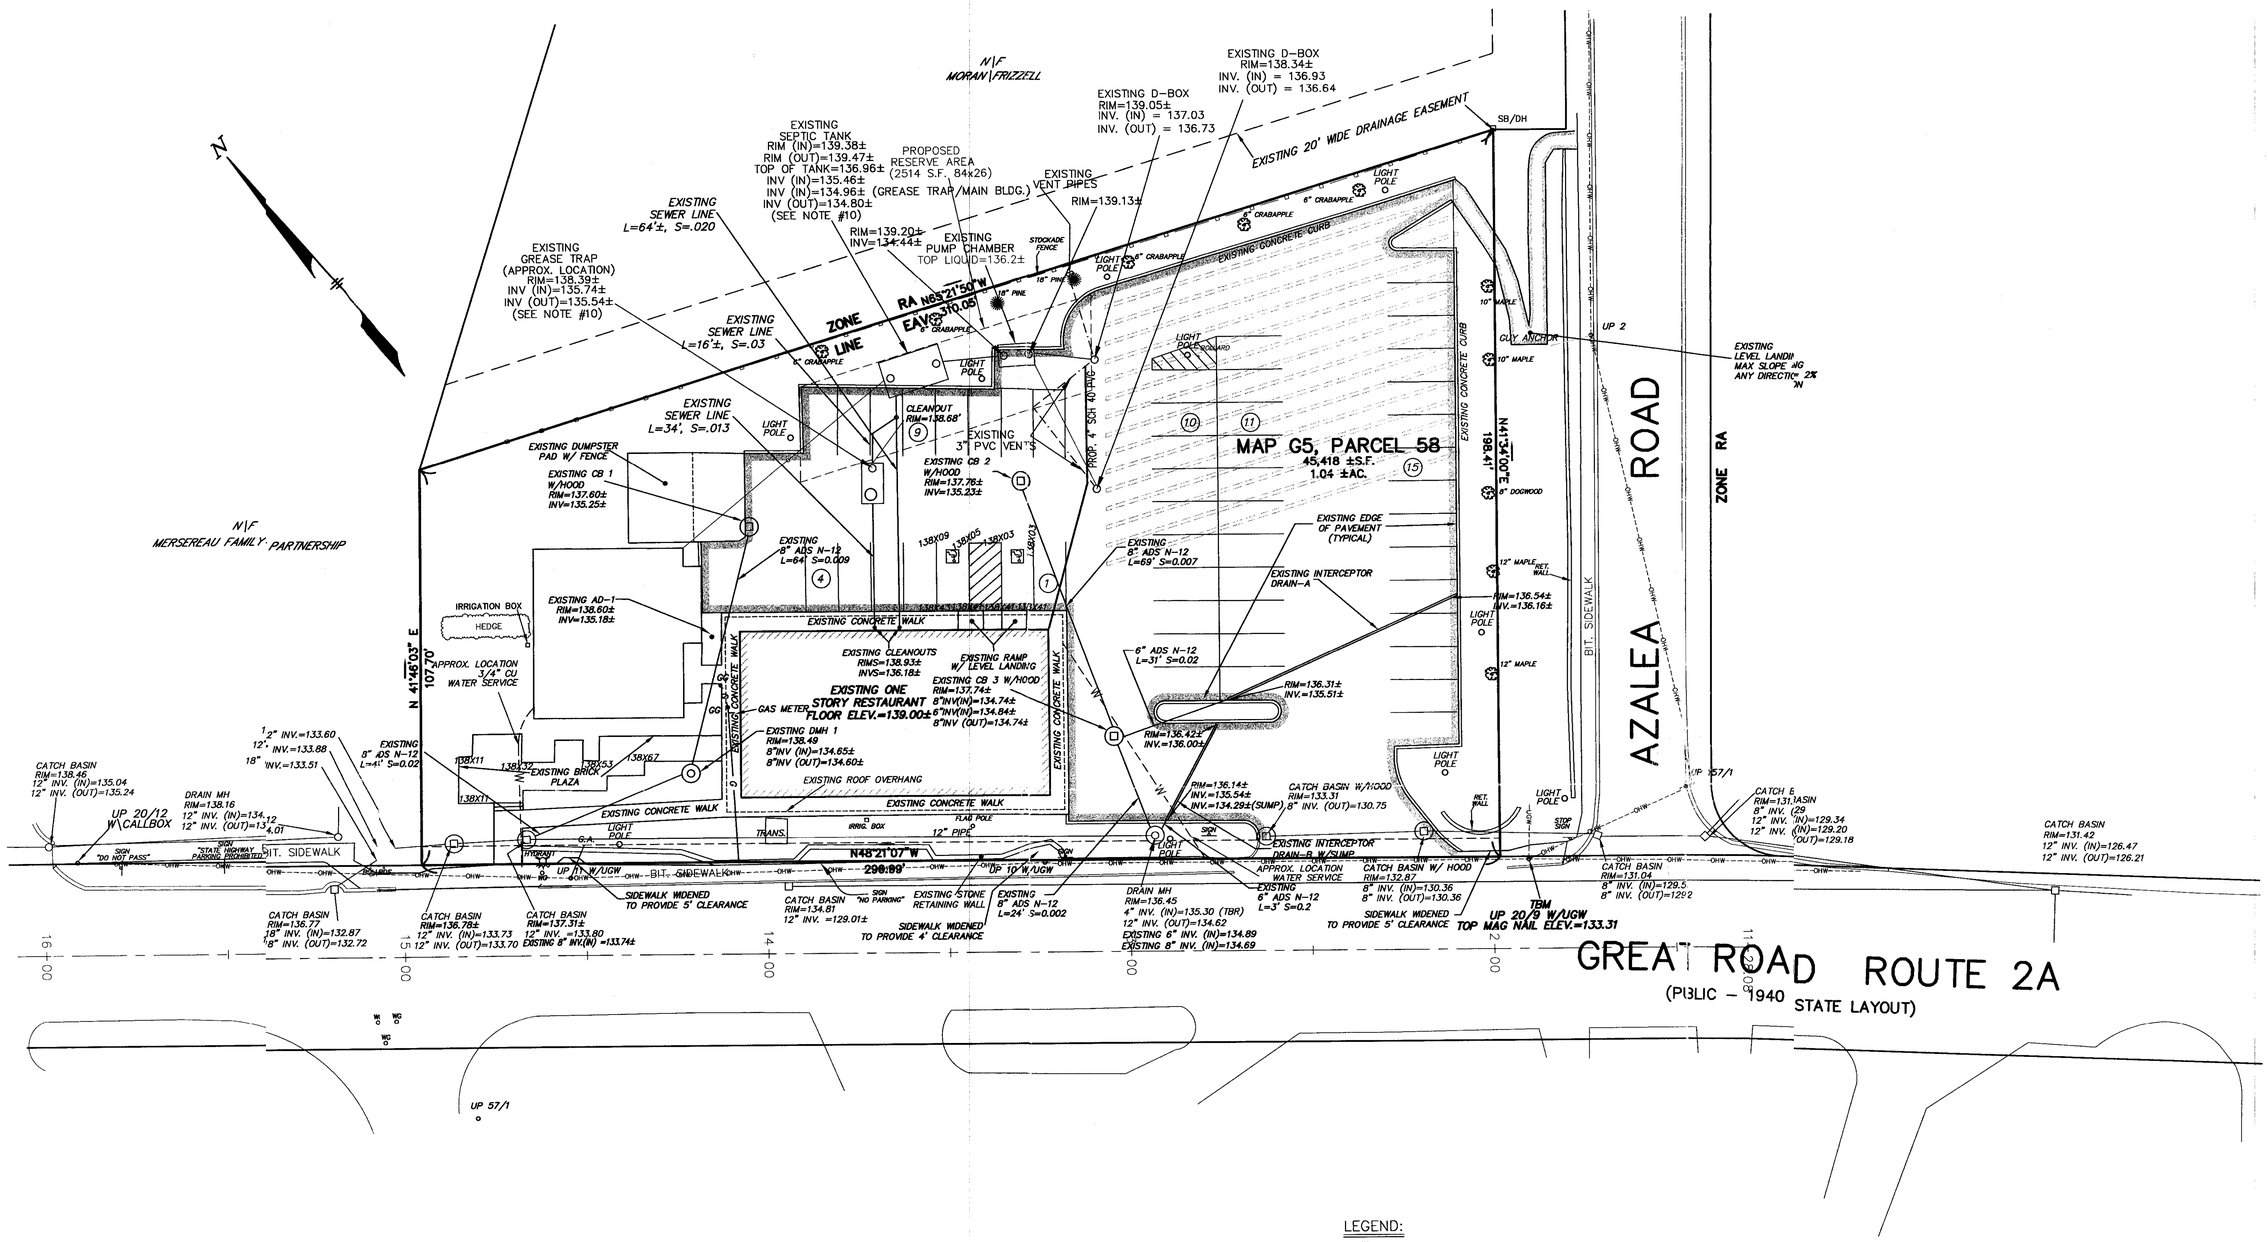

LEGEND:

N/F	NOW OR FORMERLY
——OHW——	OVERHEAD WIRES
∘ UP	UTILITY POLE
CB	CATCH BASIN
DMH	DRAIN MANHOLE
OSS	OIL/SEDIMENT SEPARATOR
ID	INLINE DRAIN
IB	INFILTRATION BED
	FIRE HYDRANT
------W------	WATER SERVICE
------G------	GAS SERVICE
99X9	EXISTING SPOT ELEVATION

I HEREBY CERTIFY THAT IN GENERAL THE PROJECT HAS BEEN CONSTRUCTED ACCORDING TO THE APPROVED SITE PLAN WITH THE EXCEPTION OF ITEMS LISTED IN A LETTER TO THE ACTON BUILDING COMMISSIONER DATED JULY 25, 2007.

7/25/07 — DATE

REGISTERED PROFESSIONAL ENGINEER

COMMONWEALTH OF MASSACHUSETTS
JOSEPH MARCH
CIVIL
040472
REGISTERED PROFESSIONAL ENGINEER

55 GREAT ROAD
AS-BUILT SITE PLAN
ACTON, MASSACHUSETTS

AS-BUILT
FOR: MCDONALDS USA, LLC
SCALE: 1"=20' JULY 25, 2007

STAMSKI AND MCNARY, INC.
80 HARRIS STREET ACTON, MASSACHUSETTS
(978) 263-8585
ENGINEERING - PLANNING - SURVEYING

0 10 20 40 60 80 FT

(379.ABSITE.DWG) SM-3792

3